Plat Book ZZ, Page 63 A

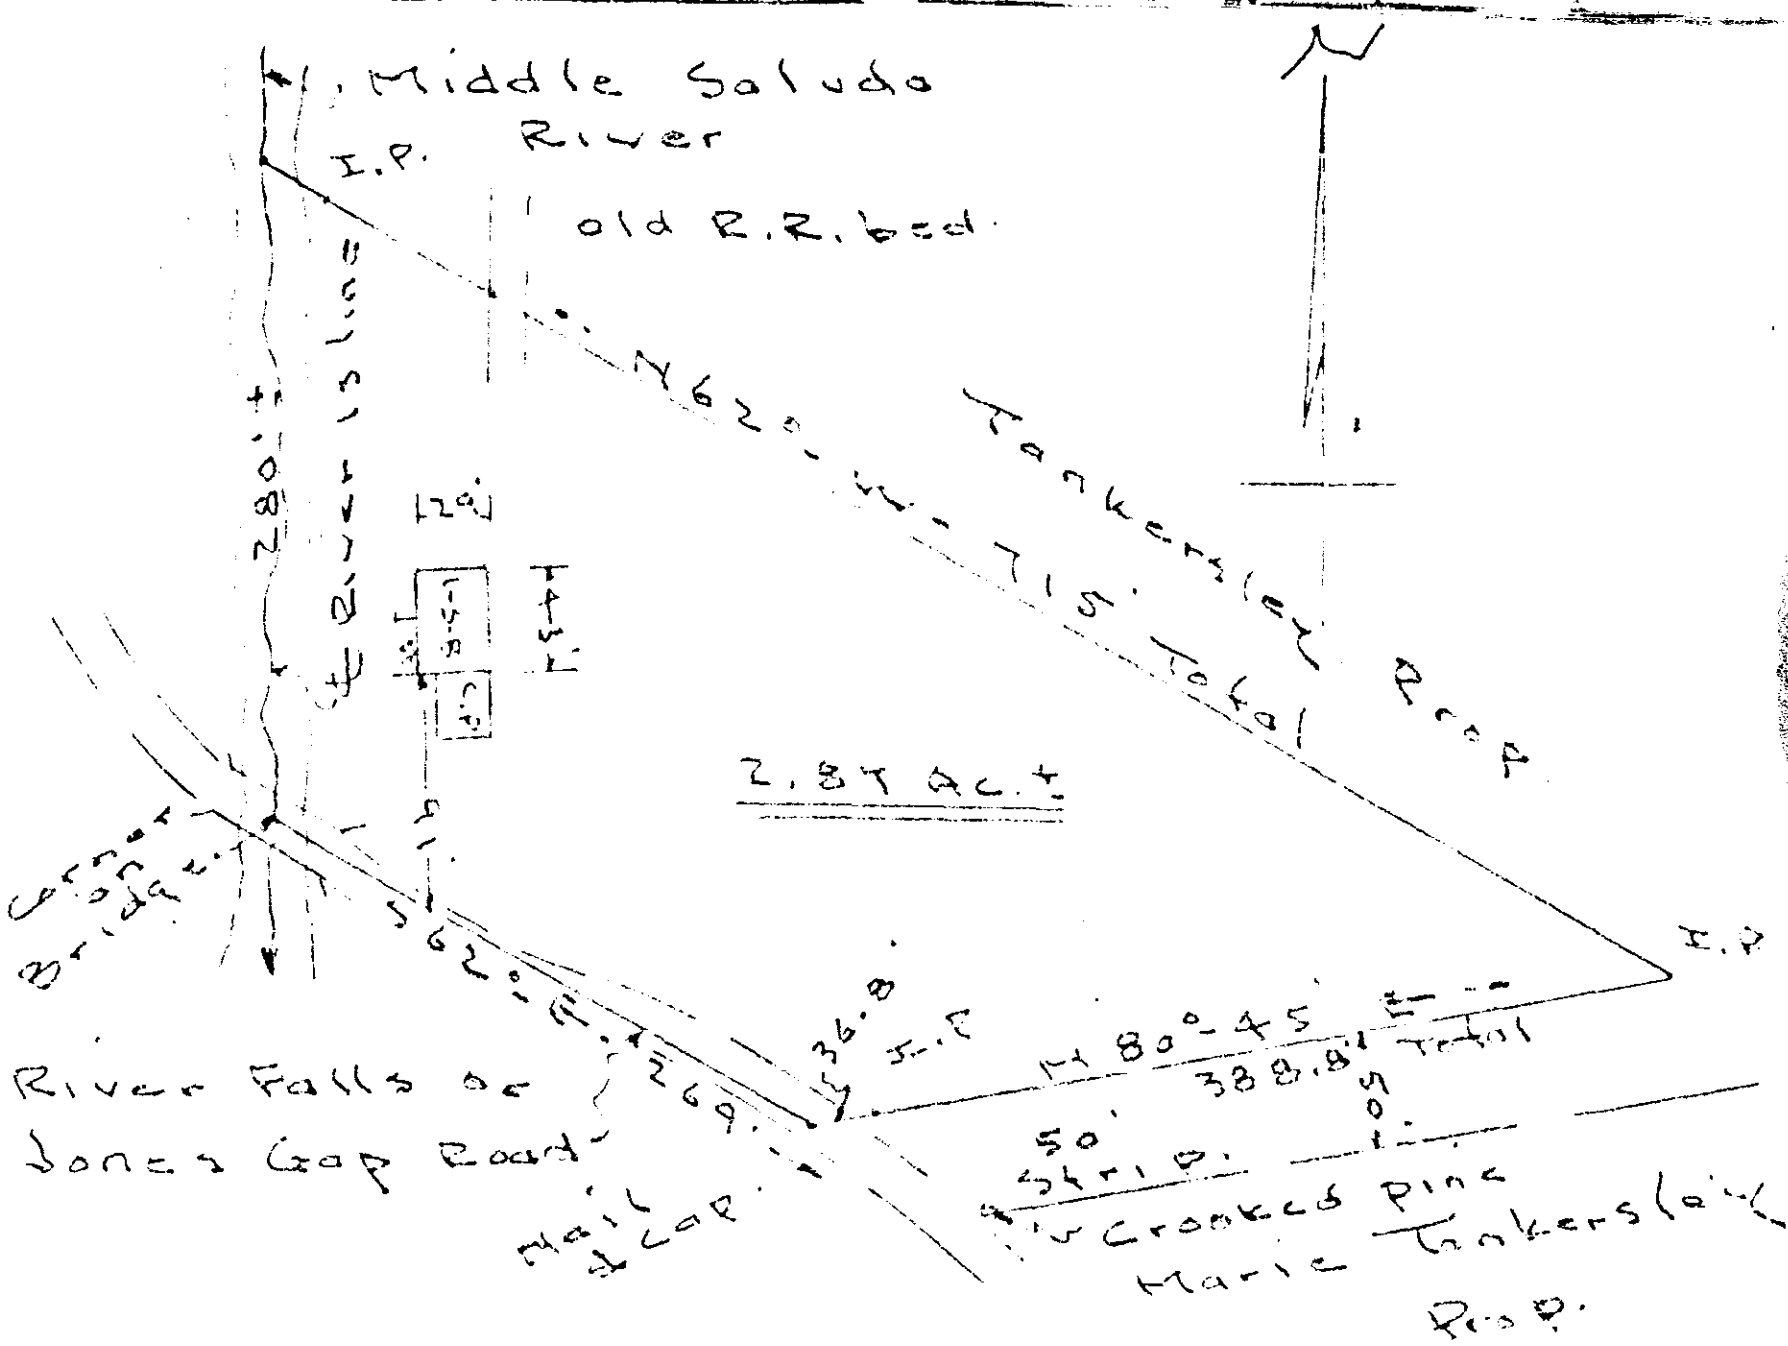

PROPERTY OF
P.D. TANKERSLEY
Near River Falls - S.C. Greenville Co.
Scale 1" = 100' - 10-3-61

This is to certify that on the 3rd. day of October, 1961, I surveyed the property shown on this plat, located on Jones Gap Road and Middle Saluda River, near River Falls, S. C. and that the property lines, walls and buildings are as shown hereon; that the buildings located on said lot do not encroach or project on adjacent roads or property, and that no adjacent buildings, or walls, encroach or project on said premises.

[signature]
Registered Land Surveyor.

10457

OCT 23 1961

22-63
Fee 50¢

10457 Filed This 23 day of Oct. 1961
And Recorded in Vol. 22 Page 63 at ____ M
[signature]
Register Mesne Conveyance Greenville County, S. C.