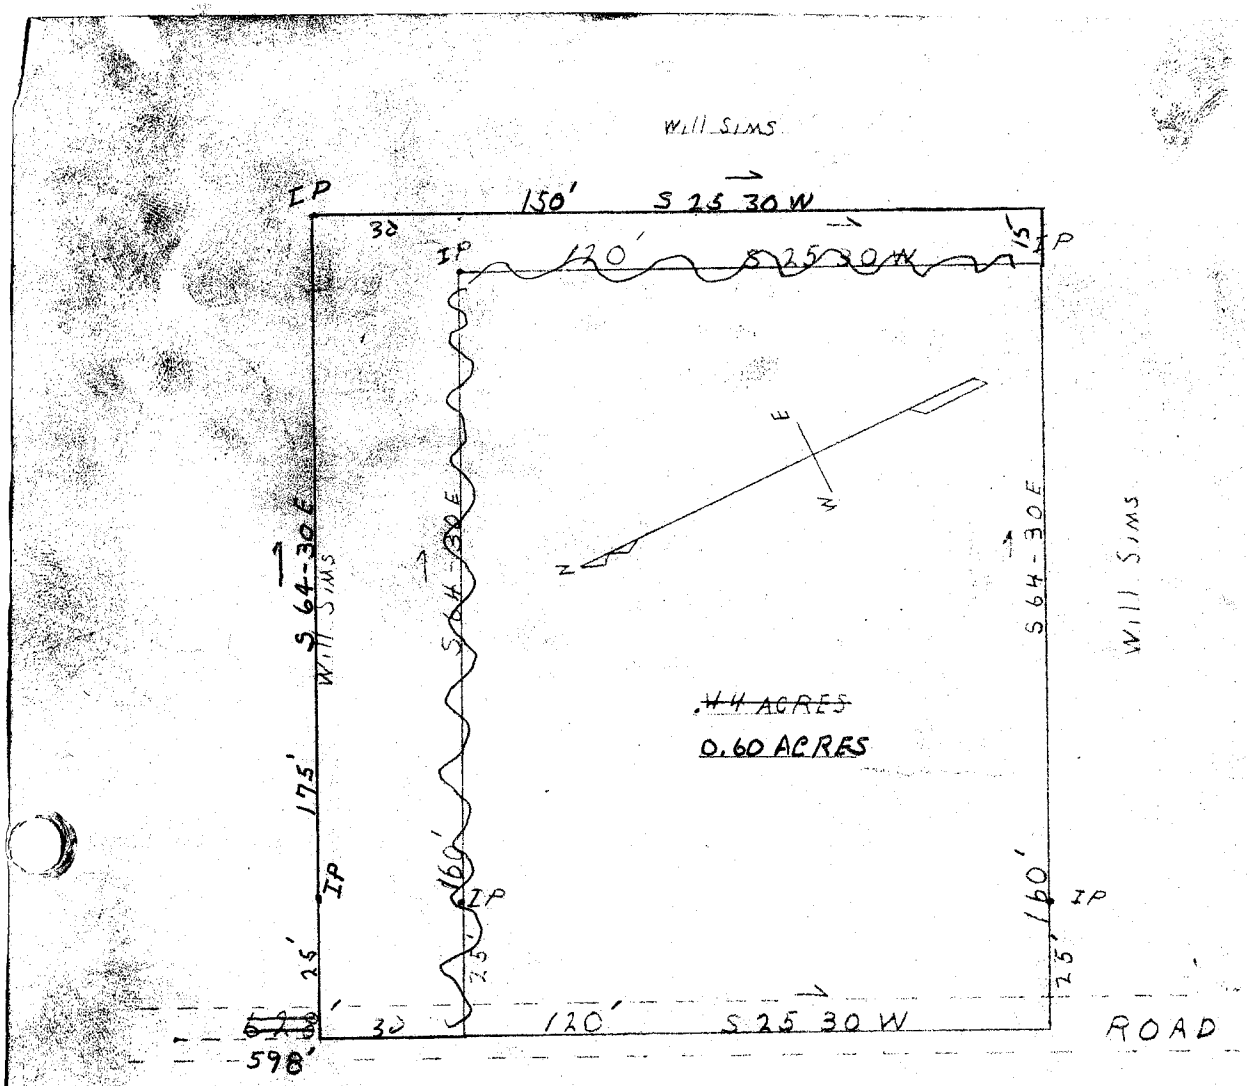

CORNER IN MIDDLE
OF DILL GOLDSMITH RD.

PROPERTY of JERRY SIMS
SEPT 10, 1960
SCALE 1" = 40'

10697

OCT 25 1961

Paste = 50¢ 22 - 67

FILED
GREENVILLE CO. S. C.
OCT 25 10 28 AM 1961

D6697 Filed This 25 day of Oct. 19 61
and Recorded in Vol. 772 Page 67 at 11
Register Mesne Conveyance Greenville County, S. C.