


14501 Filed This 8 day of Dec- 1961  
 And Recorded in Vol 22 Page 105 of  
 Register Means Conveyance Greenville County, S. C.

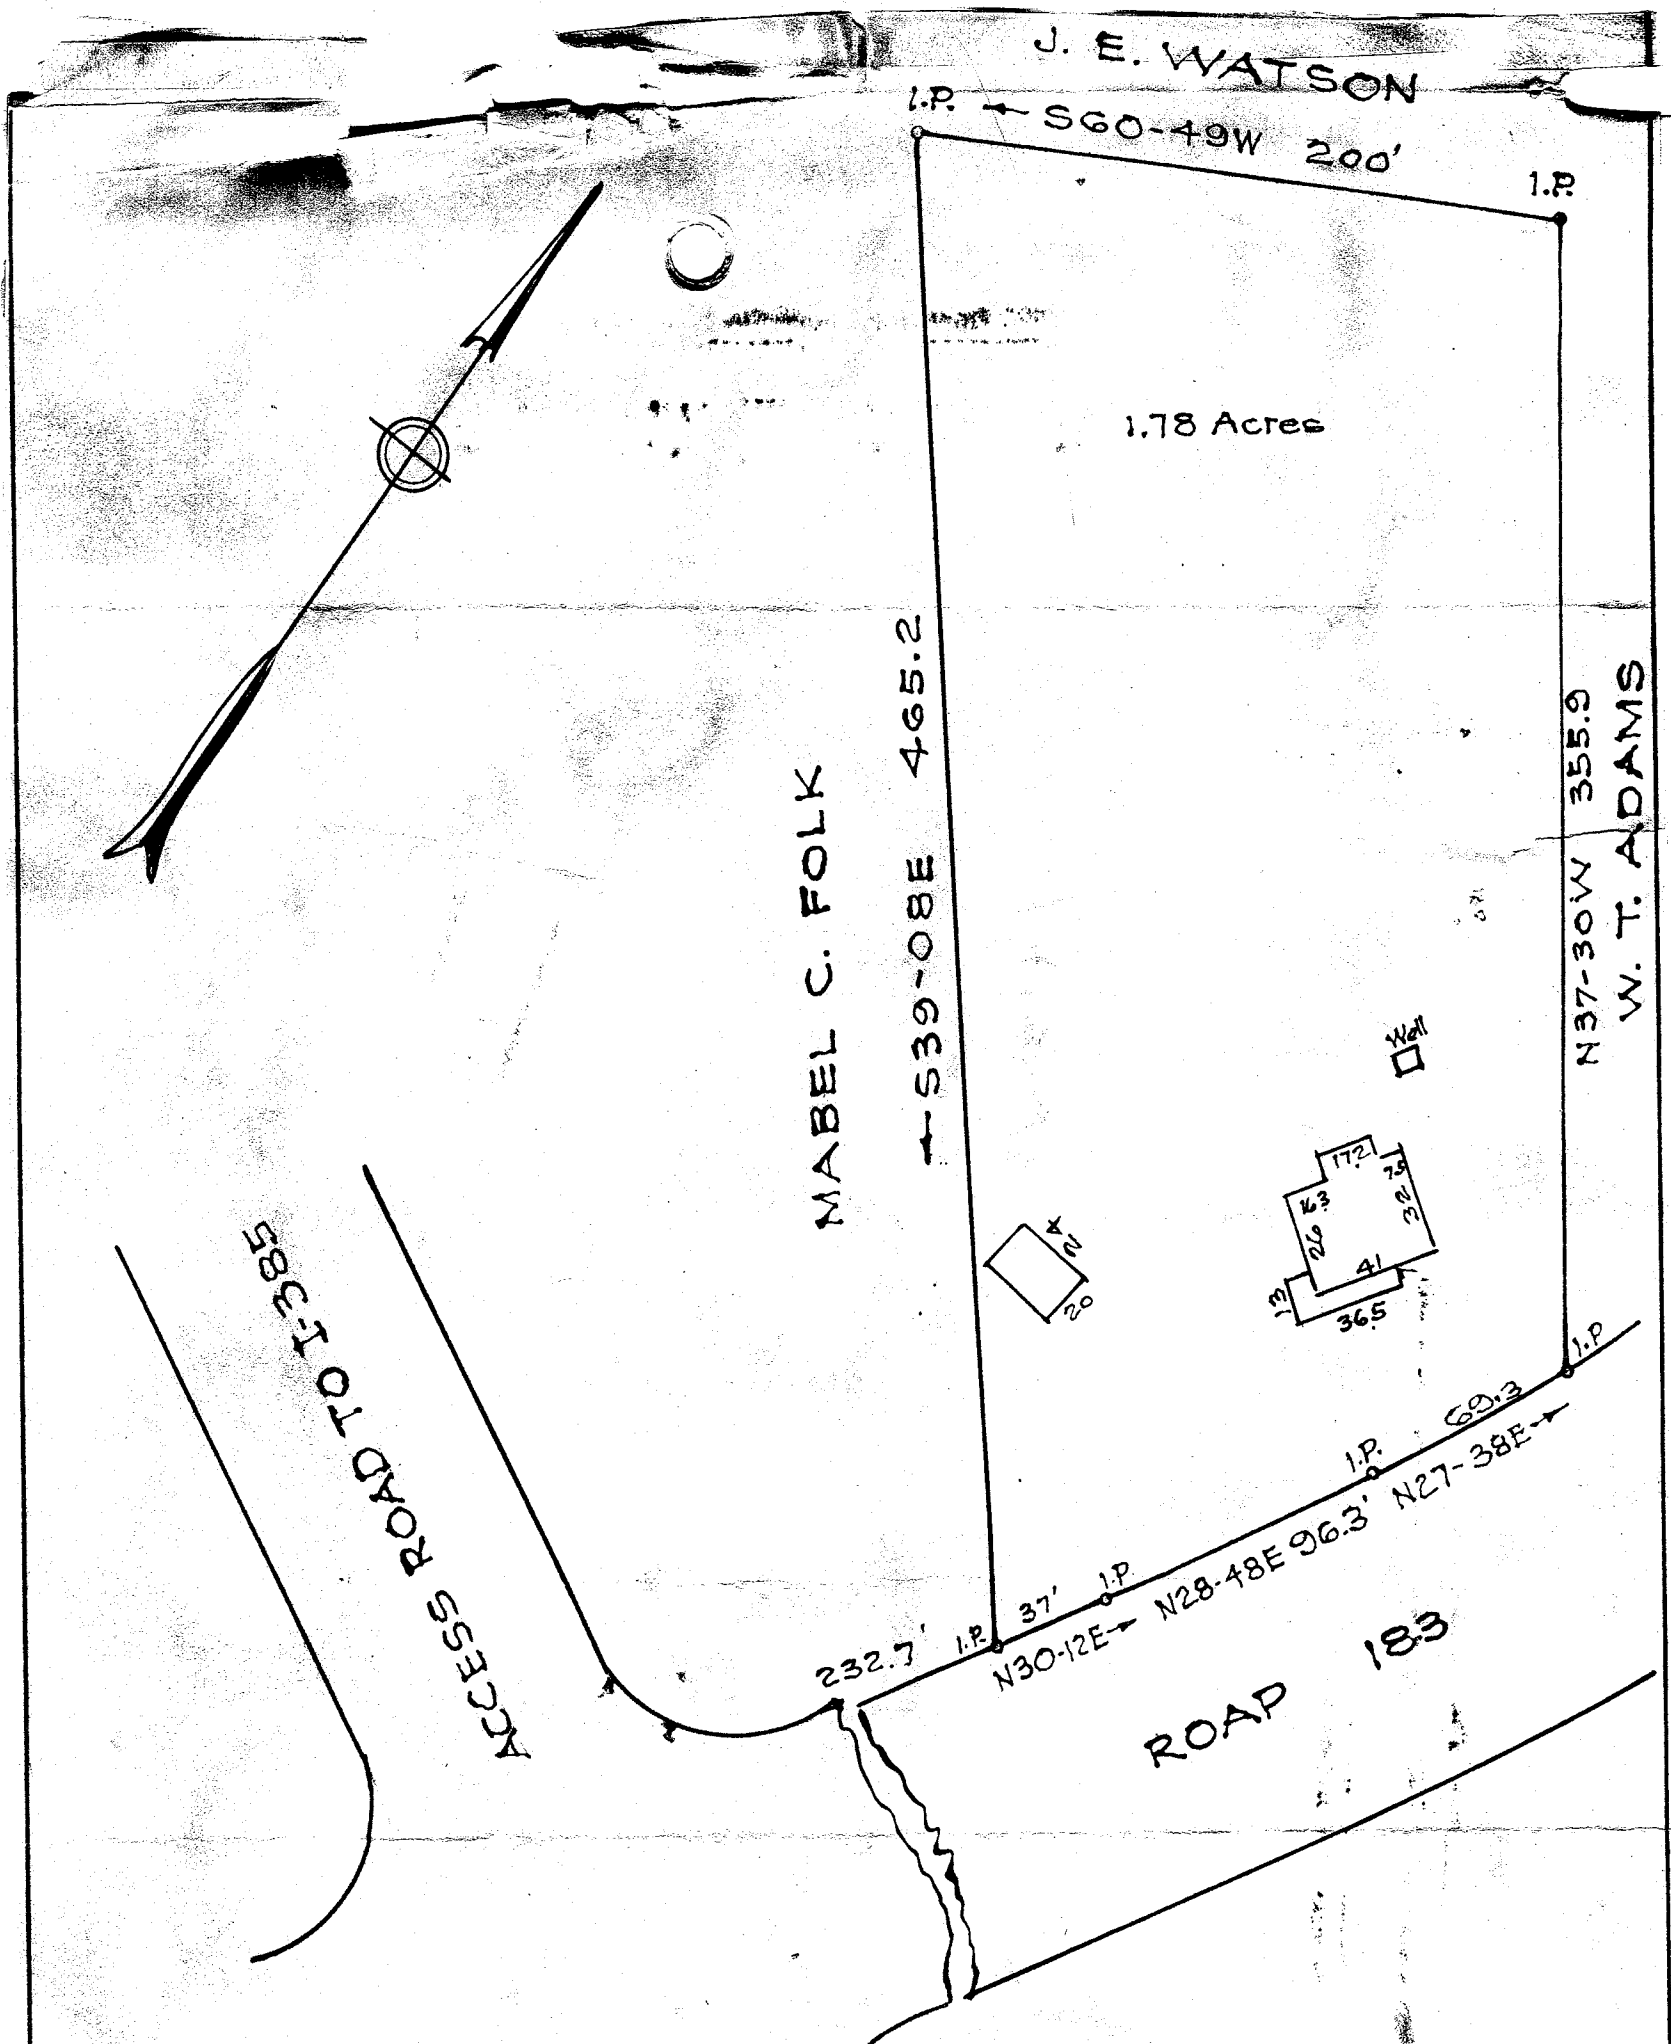

14501  
 DEC 8 1961

PROPERTY OF  
 FRANKLIN AUGUSTAS FOLK  
 GREENVILLE CO. S. C.  
 Scale 1"=60' Dec. 1961

This is to certify that on the 5th day of December, I surveyed the property shown on this plat; being shown on plat of Franklin Augustas Folk, Recorded in Plat Book ZZ page 105, Office of R. M. C. Greenville Co., S. C.; and that the property lines, walls and buildings are as shown hereon; that the buildings located on said lot do not encroach or project on adjacent streets or property; and that no adjacent buildings or walls encroach or project on said premises.

*R. W. Dalton*  
 Dalton & Neves, Engineers.

DEC 8 1961  
 OLLIE FARNSWORTH  
 R.M.C.

33-105

105