


NOTE: Plat amended July 1, 1962, showing new street below lot #4 & rearrangement of lots 5 thru 8 into 5, 6 & 7 as shown.

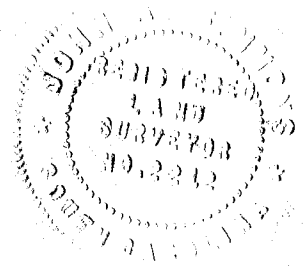

NOTE: Plat amended March 9, 1961, to show 36' street.

NOTE: 5' Drainage Easement to all lot lines, 25' on both sides of dividing lines.

NOTE: Iron pins at all corners.

PROPERTY OF
J. R. FRIDDLE.

Located in Greer.

CHICK SPRINGS TOWNSHIP GREENVILLE COUNTY,
SOUTH CAROLINA.

SCALE: 1" = 100 FEET.

JUNE 20 1960.

Survey made June 8, 1960.

1773
JUL 16 1962
JUL 16 10 41 AM 1962
GREENVILLE, S.C.
OLLIE FARMWORTH
R.M.C.

33-170

John A. Simmons - Reg. Surveyor #2212
GREER, S.C.

1973 Filed This 16 day of July 1960
in and recorded in 33-170
Ollie Farmworth
Registered Professional Land Surveyor Greenville County, S.C.

J.R. Friddle
50