


DUNHAM  
BRIDGE ROAD

OLDEASLEY BRIDGE ROAD

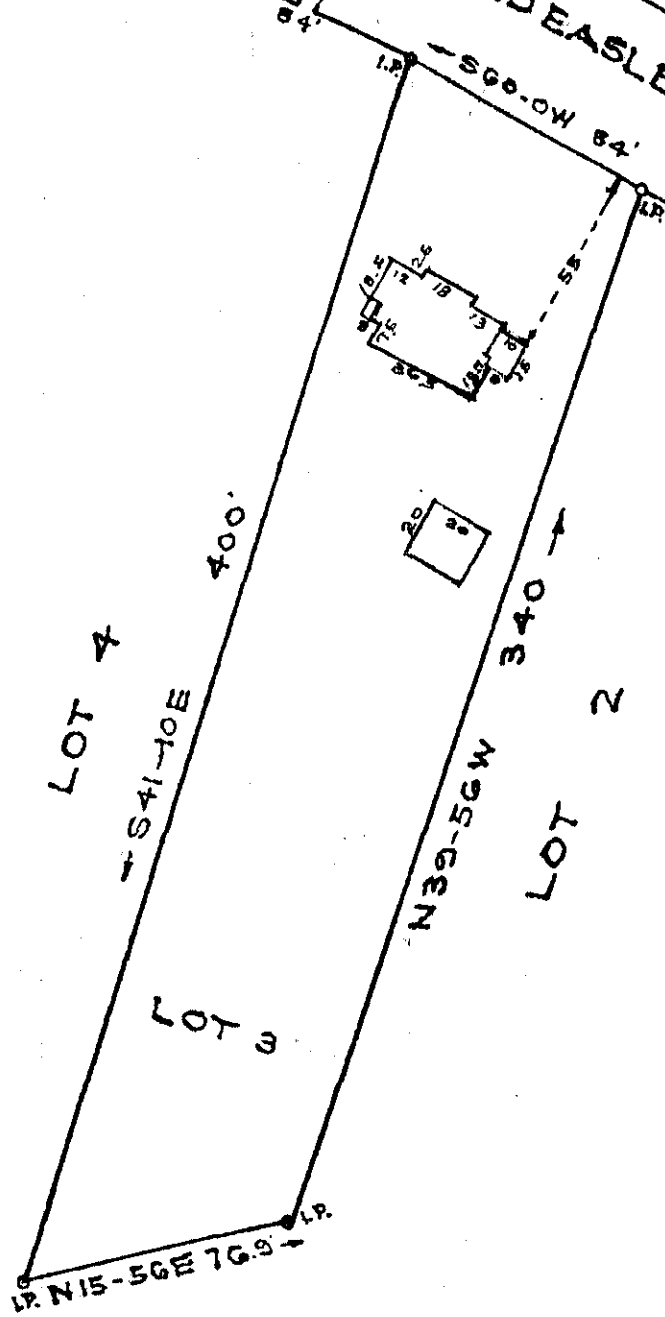

OLLIE F. TROTTER  
R.M.C.

APR 23 9 59 AM 1962

GREENVILLE CO. S.C.

PROPERTY OF  
B. G. TROTTER  
OLLIE F. TROTTER  
GREENVILLE CO.S.C.  
Scale 1"=60' April 1962

This is to certify that on the 20th day of April, 1962, I surveyed the property shown on this plat; being known as Lot 3 on plat of B. G. Trotter and Ollie F. Trotter, Recorded in Plat Book AAA page 59 Office of R. M. C. Greenville Co., S. C.; and that the property lines, walls and buildings are as shown hereon; that the buildings located on said lot do not encroach or project on adjacent streets or property; and that no adjacent buildings or walls anroach or project on said premises.

APR 23 1962

26188

*R. W. Dalton*  
Dalton & Neves, Engineers.

paste in .50

AAA-59