


Plat Commission Approved 9/14/64
FINAL PLAN APPROVED
 GREENVILLE CITY PLANNING & ZONING COMMISSION
 DATE *10/19/64* BY *J.B. Bates*
 SECRETARY OF COMMISSION

THEODORE

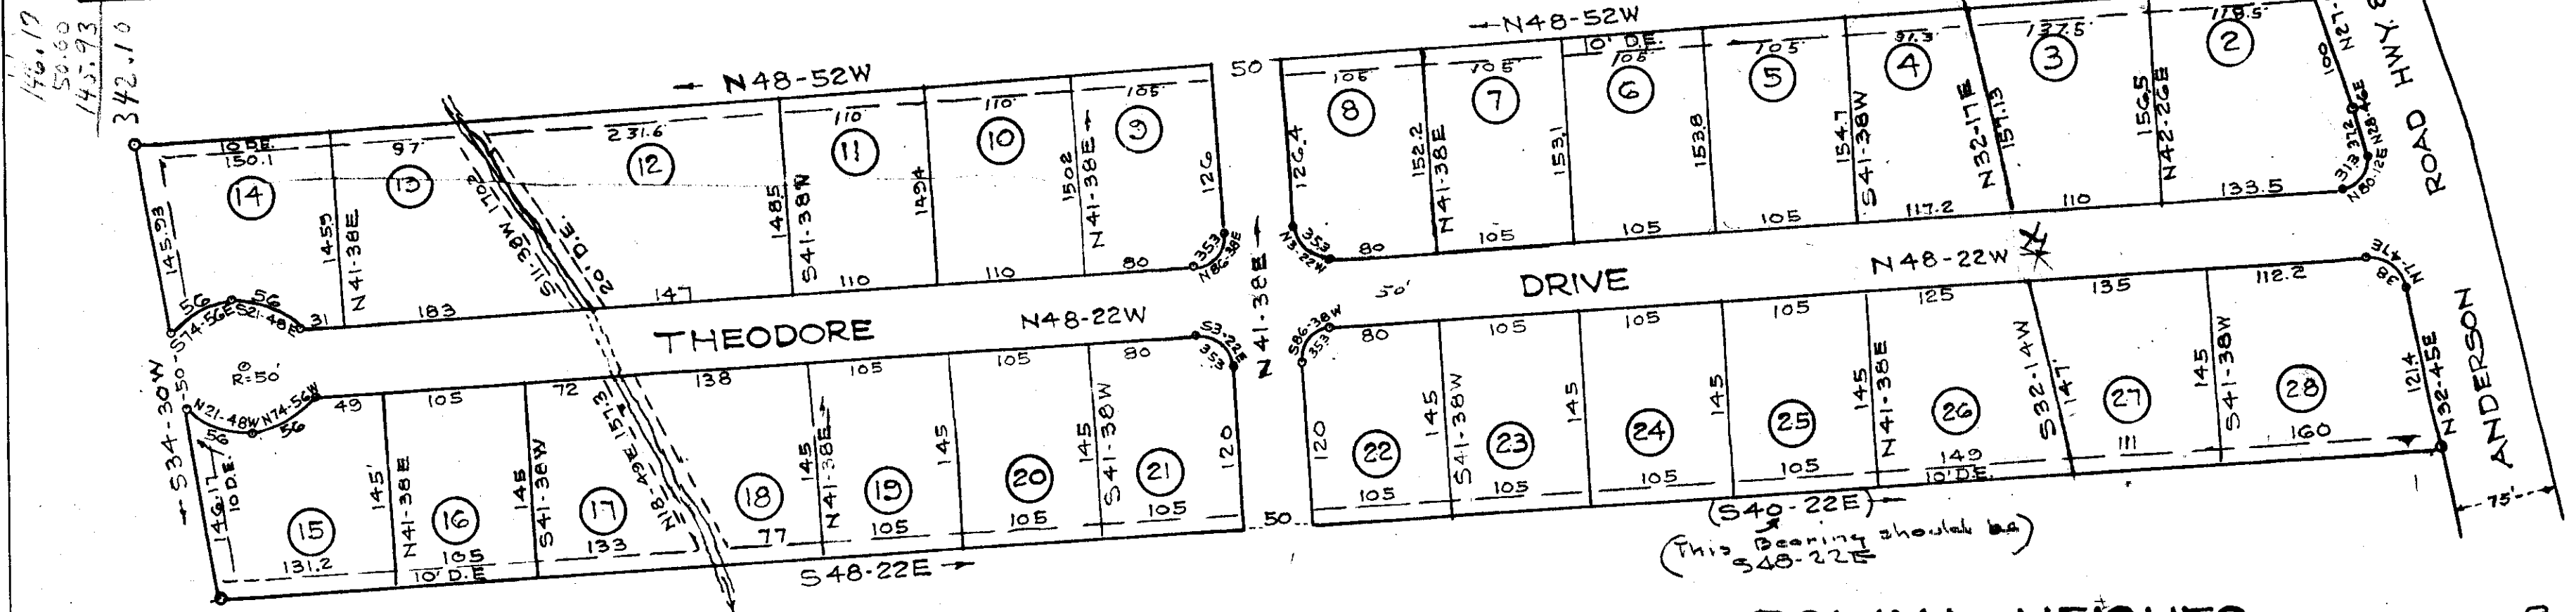

CAROLINA HEIGHTS

PROPERTY OF
DEMPSEY CONSTRUCTION CO. INC.
 GREENVILLE CO. S. C.

Scale 1"=100' August 1964

DALTON & NEVES
 ENGINEERS

This is to Certify that I am the
 Owner of this property and approve
 of the subdivision as shown hereon.
Ray T. Dempsey, Pres.
 2823 White Horse Road
 Greenville, S.C.
R.W. Dalton
 I Certify the above survey is correct
 Iron Pins at all Corners

1.25
000-29

OCT 19 3 54 PM 1964
 OLIE FARRSWORTH
 R.M.C.
 11485

11485 Filed This day of *Sept* 19 *1964*
 And Recorded in Vol. *1313* Page *29* at *M*
R.W. Dalton
 Register Meane Conveyance Greenville County, S. C.