


FILED
GREENVILLE CO. S. C.
MAY 30 10 47 AM 1966
OLLIE FARNSWORTH
R.M.C.

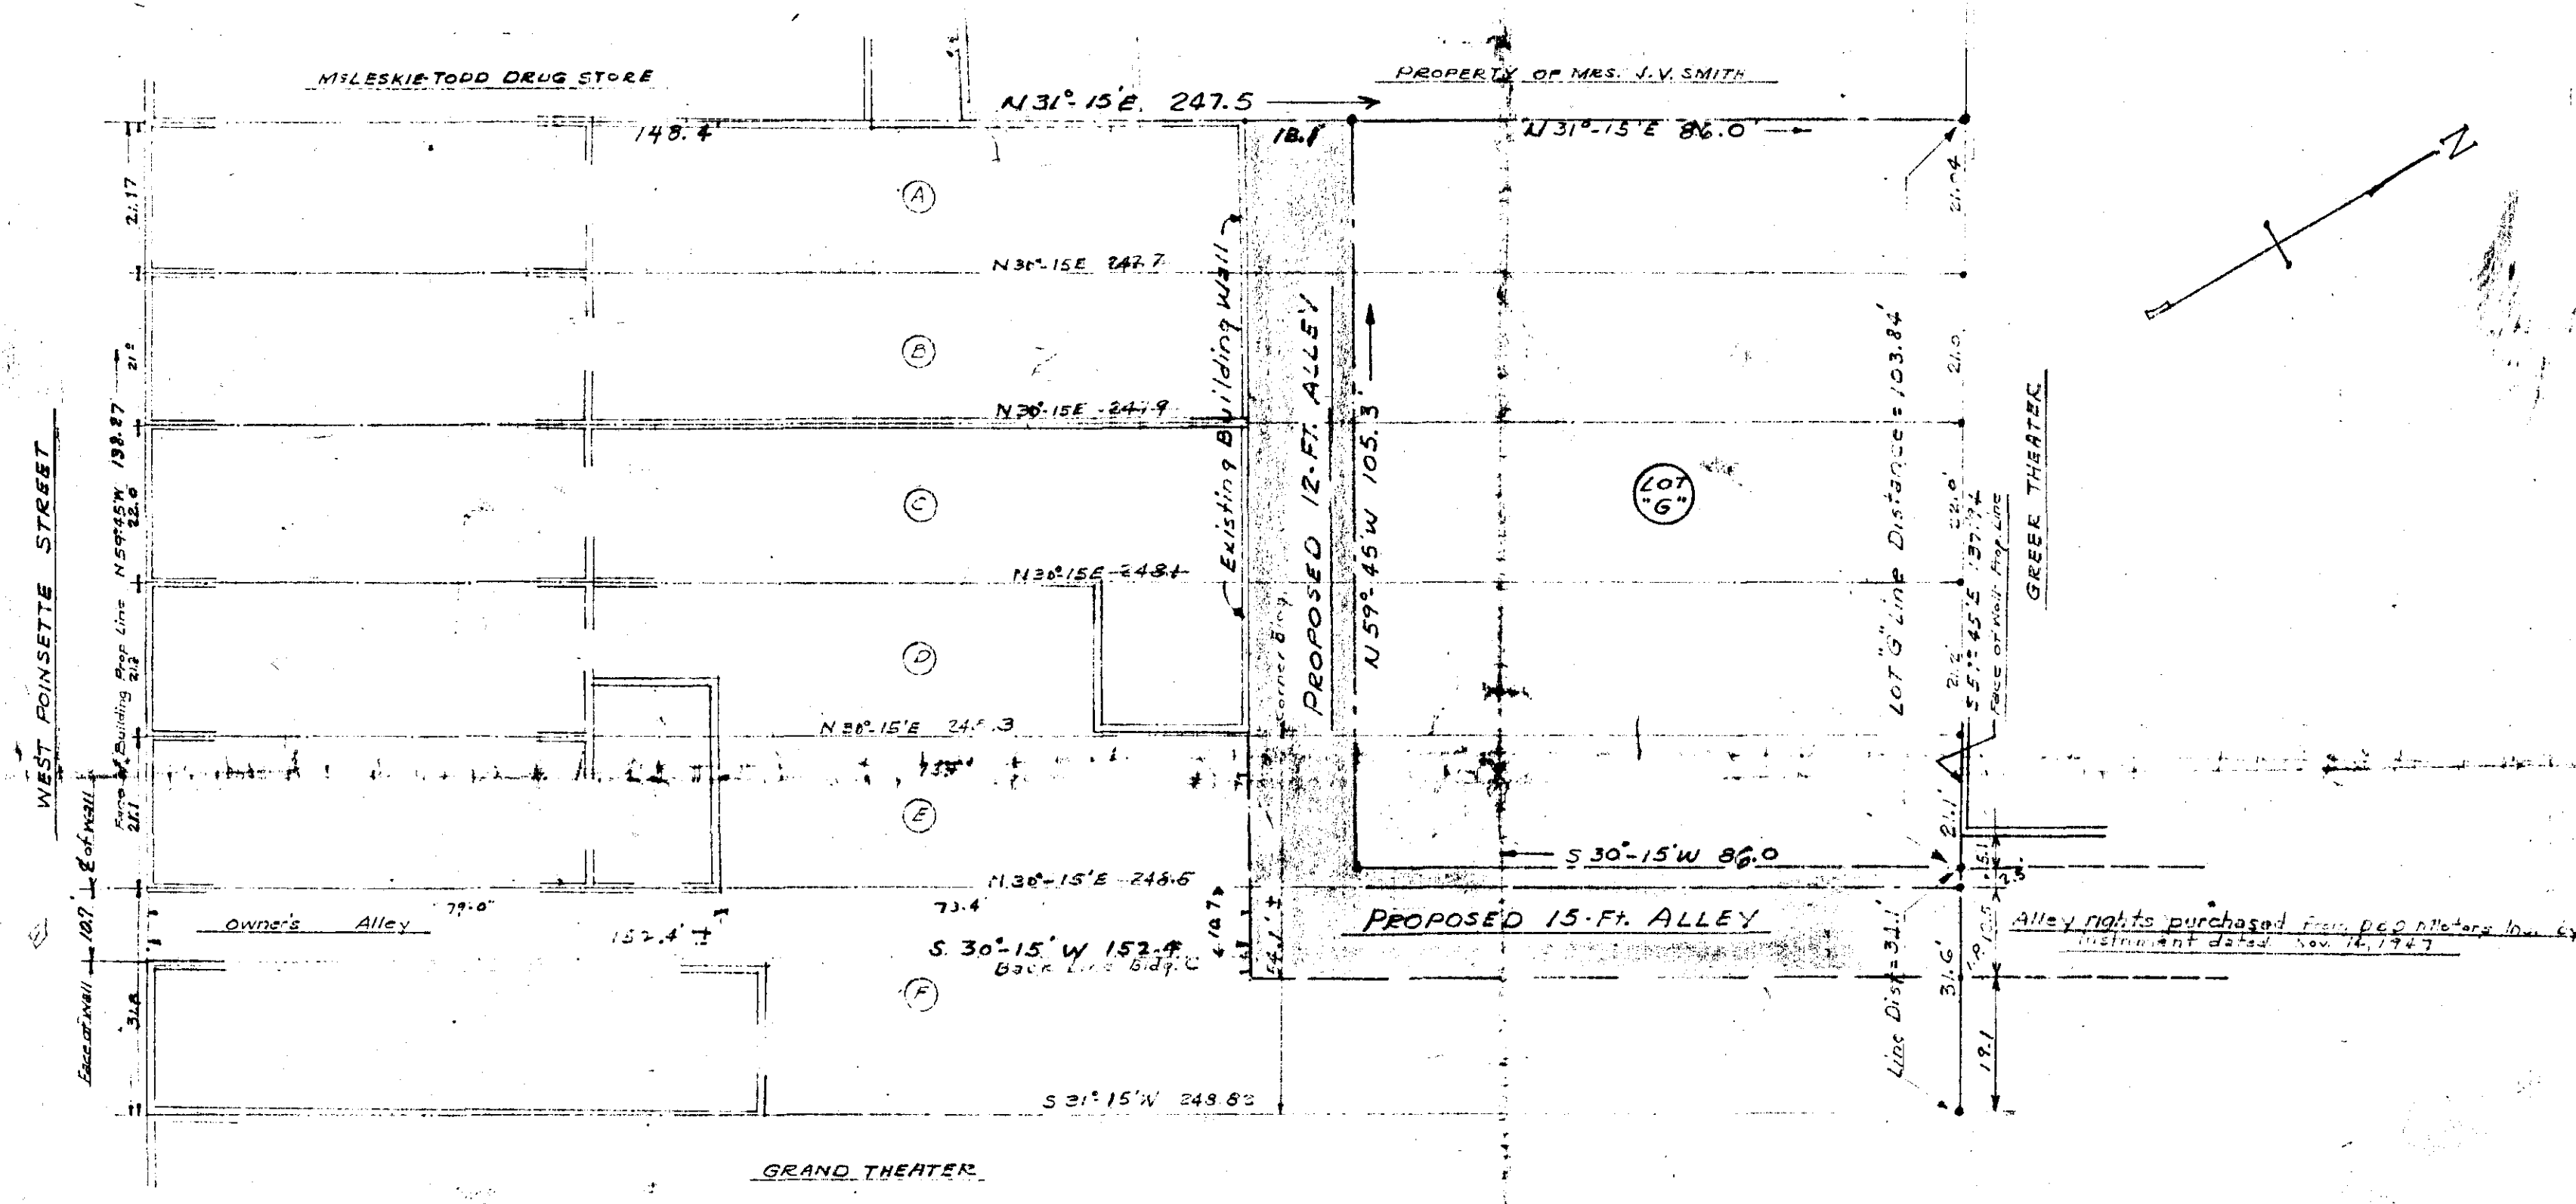

Note: Lots A, B, C, D, E, & F as shown above are not changed by Revision No. 2 except for the PROPOSED 15-Ft. & 12-Ft. Alley and the cutting off of LOT C as indicated.

B. B. Waters, Jr. 4-20-66
1098

PROPERTY OF
BELL S. CUNNINGHAM
CITY OF GREEN, CHICKSPRINGS TOWNSHIP
GREENVILLE COUNTY, SOUTH CAROLINA
Dated: 9-10-51 Scale: 1"=20'
Survey by B. B. Waters, Jr., Lic. No. 1093

BBB-198 33941

2 Revised 4-22-66 Lot "G" Indicated - Alley Ext.
1

33941 Filed This 30 day of May 19 66
And Recorded in Vol. BBB Page 198 at 11:47 AM
Ollie Farnsworth
Register Mesne Conveyance Greenville County, S. C.