GREENVILLE CO. S. C.
NOV 6 12 07 PM 1962
OLLIE FARNSWORTH
R. M.C.

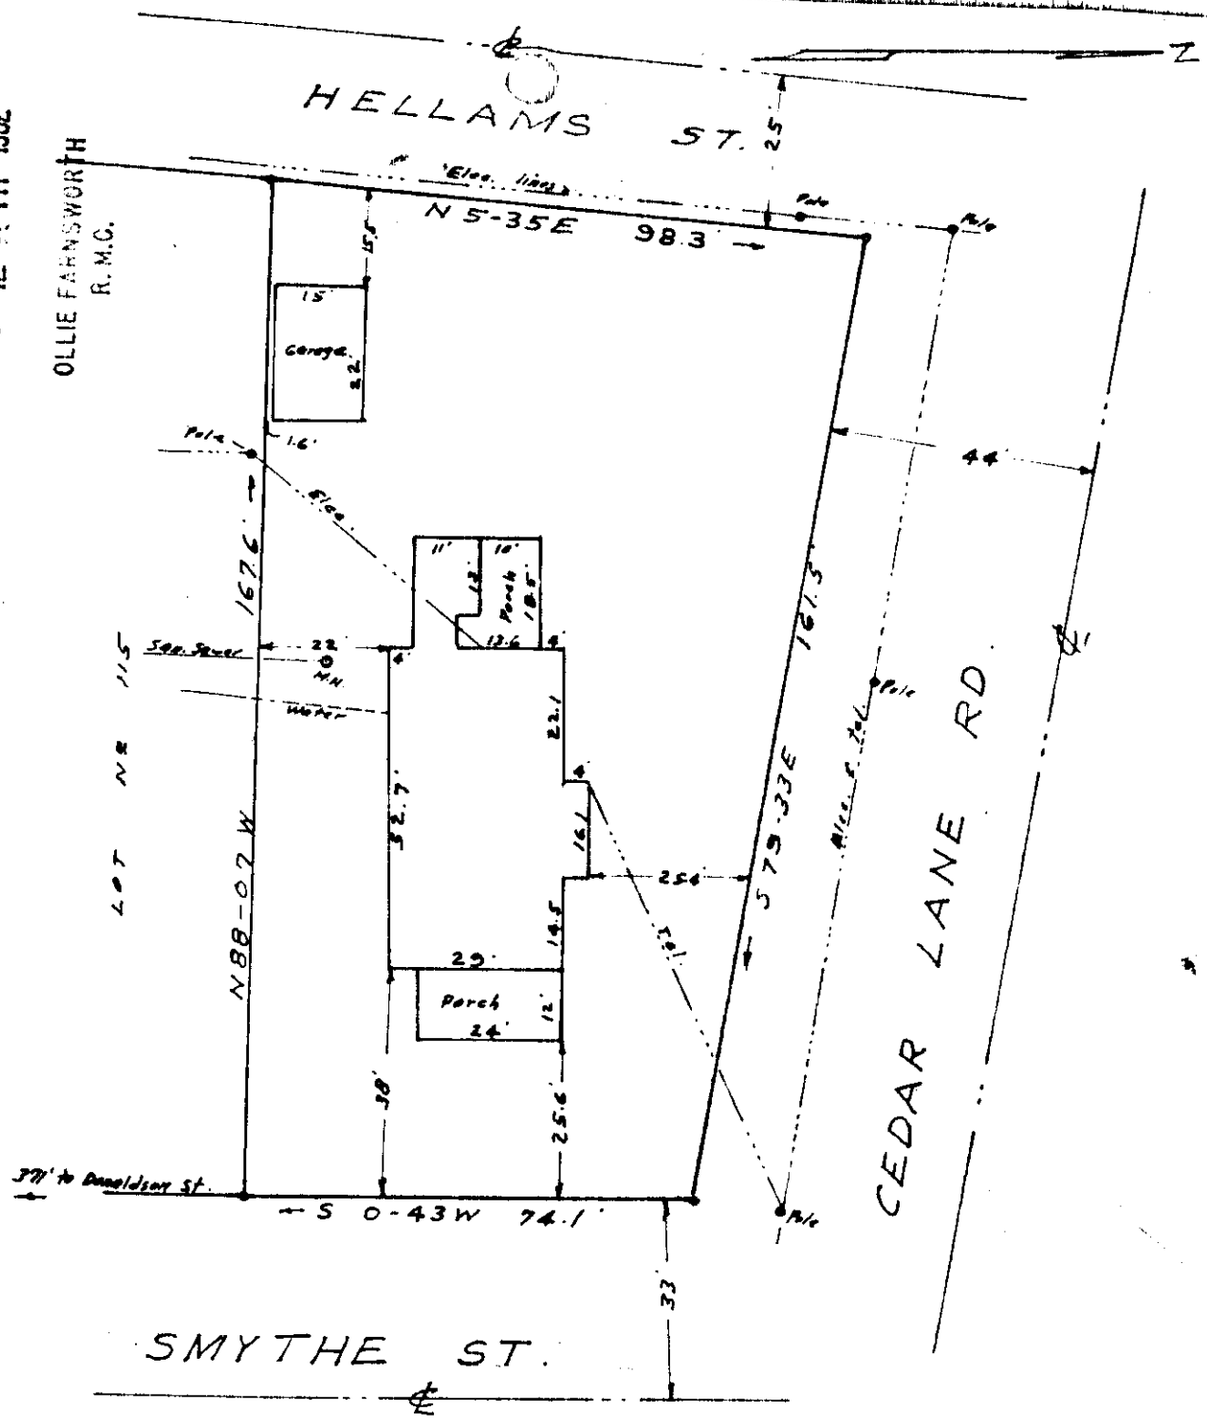

PROPERTY OF
PAUL EDWIN THOMAS
NEAR GREENVILLE S. C.
NOV. 5 1962 SCALE 1"=30'

This is to certify that on the 5th day of Nov. 1962, I surveyed the above property, located in Monaghan Mill Village, and shown on plat of property of J. P. Stevens Co. Inc. Prepared by Pickell & Pickell Engrs. dated Feb. 15th 1954, and plat of property of Paul Edwin Thomas by C. O. Riddle L. S. recorded in R. M. C. office for Greenville Co. in Plat Book CCC, Page 39, and that the property lines, walls and buildings are as shown hereon; that the buildings located on said property do not encroach or project on adjacent streets or property; and that no adjacent buildings, walls or power lines encroach or project on said premises except as shown hereon.

NOV 6 1962 12028

C. O. Riddle - Reg. L.S. # 1347

CCC - 39 See 50

12028 Filed This 6 day of Nov. 19 62
And Recorded in Vol. CCC Page 39 at M
Eddie Farnsworth
Register Mesne Conveyance Greenville County, S. C.