


WADE HAMPTON BOULEVARD
U. S. HIGHWAY NO. 29

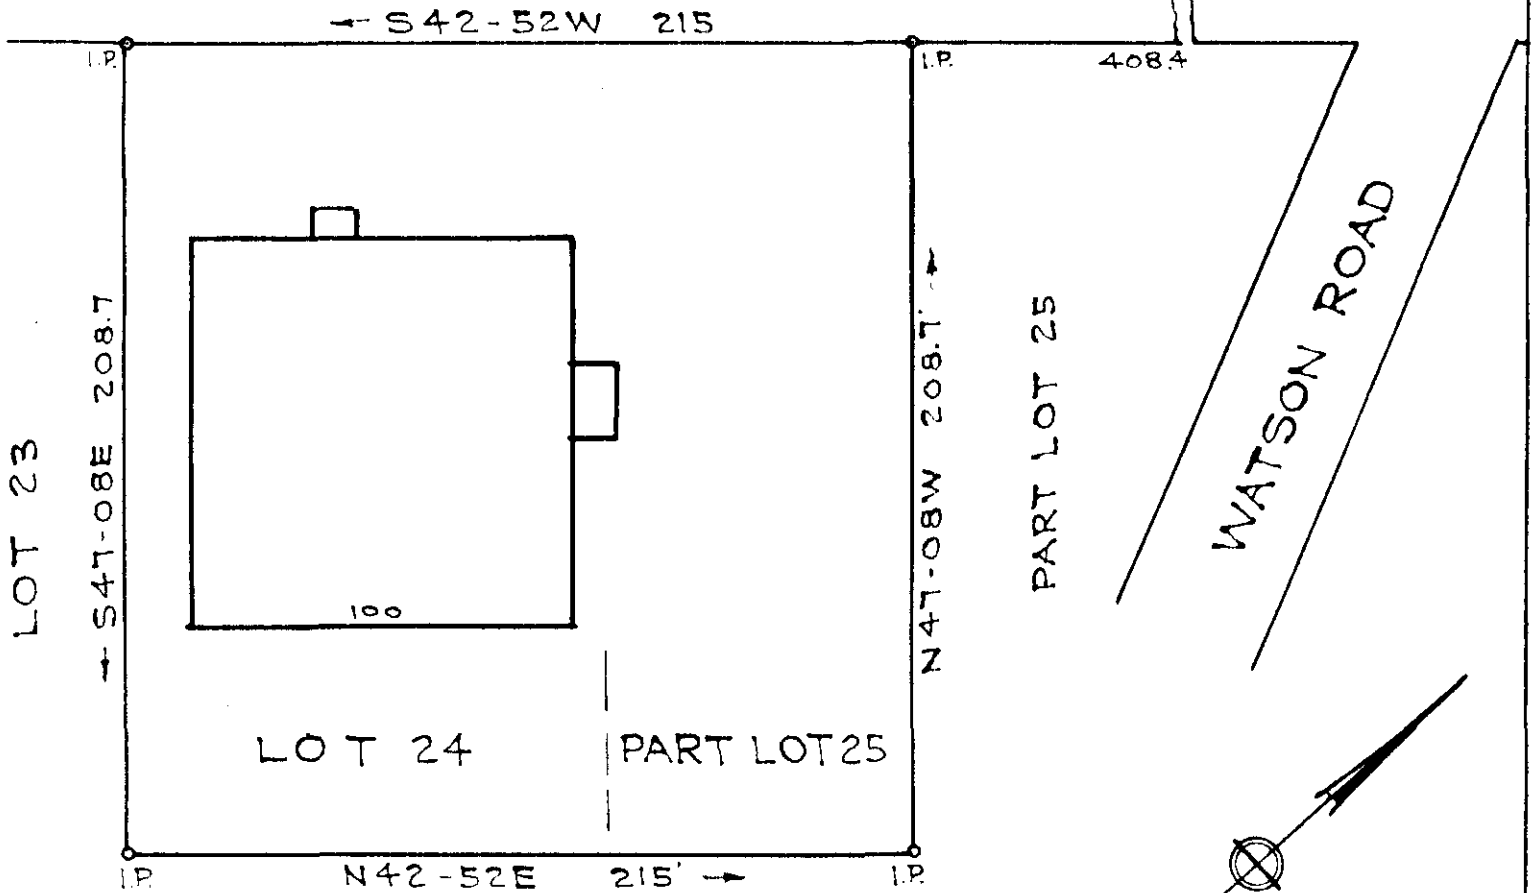

PROPERTY OF

NICANNO REALTY CORPORATION
GREENVILLE COUNTY S.C.

Scale 1"=50' December 1962

This is to certify that on the 20th day of December, 1962, I surveyed the property shown on this plat; being known as Lot 24 and part of Lot 25 on plat of Estate of Vance Edwards, Recorded in Plat Book P page 128, Office of R. M. C. Greenville Co., S.C.; and that the property lines, walls and buildings are as shown hereon; that the buildings located on said lots do not encroach or project on adjacent streets or property; and that no adjacent buildings or walls encroach or project on said premises.

1962 Filed This 20th day of Dec 19 62
 And Recorded in Vol. 95 Page 77 at
 Register Means Conveyance Greenville County, S. C.

50 16210

B. W. Dalton

DEC 27 1962

DALTON & NEVES, ENGINEERS.

CCC-77