



JUL 25 1963 2939

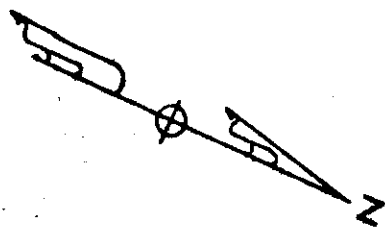

37

36

35

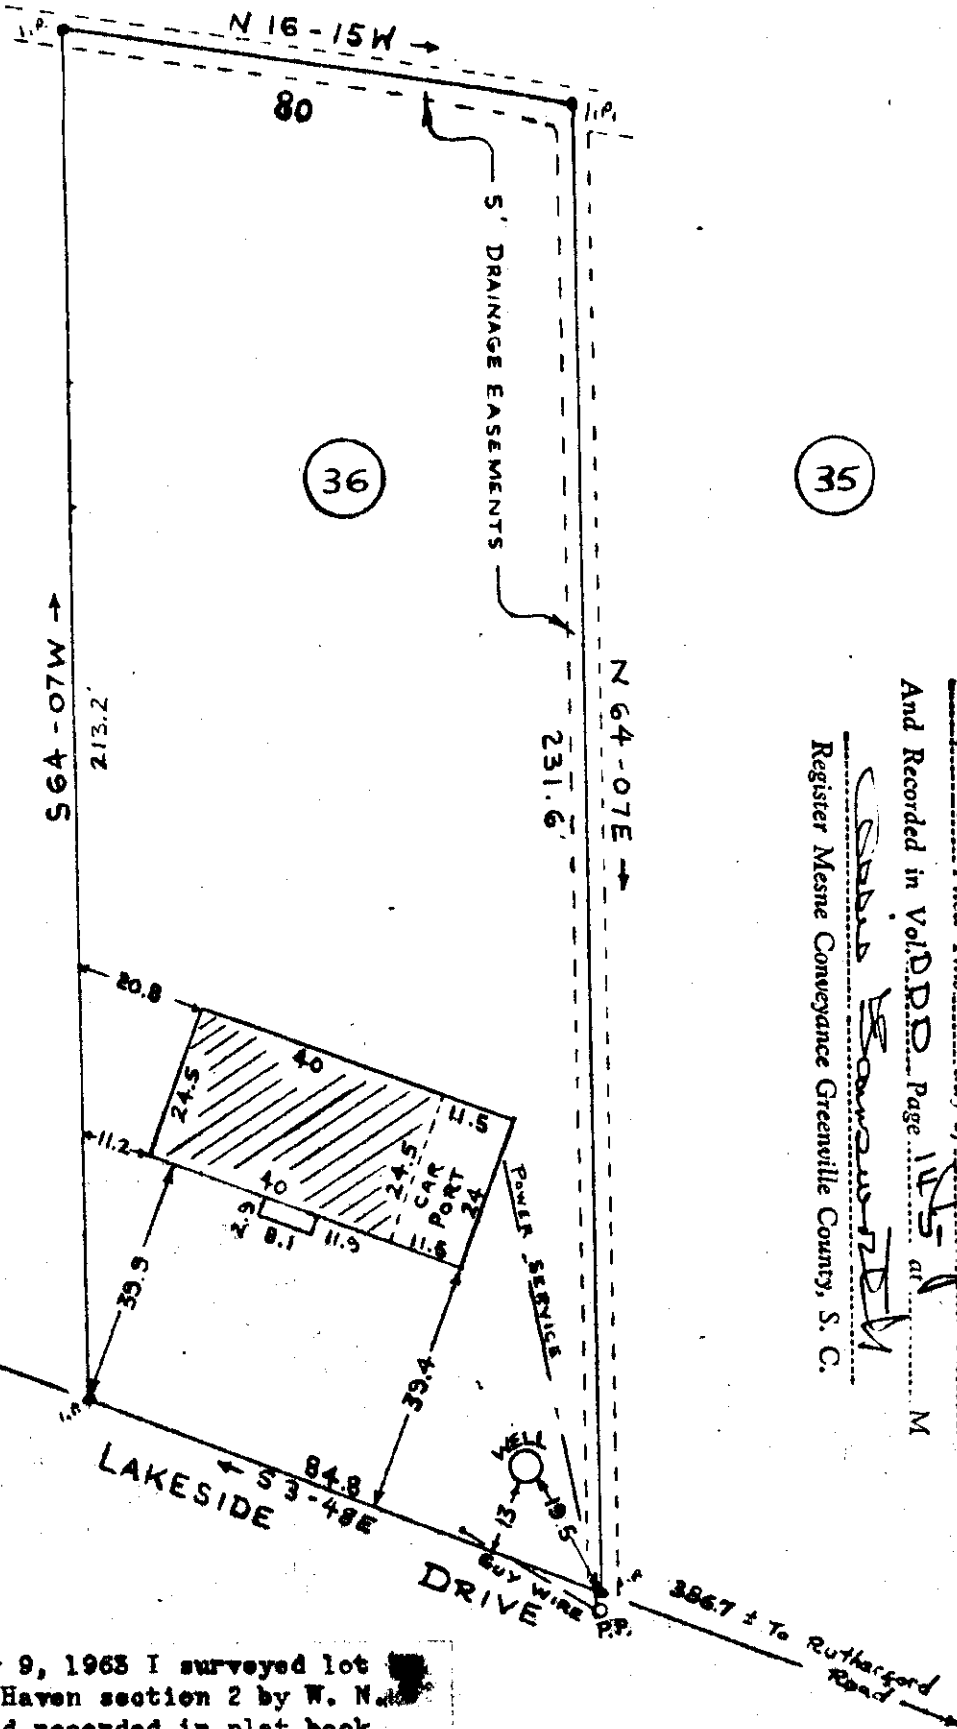

2939 Filed This 25 day of July 19 63
 And Recorded in Vol. DDD Page 145 at M
 Register Mesne Conveyance Greenville County, S. C.
 Ollie Farnsworth

GREENVILLE CO. S. C.
 JUL 25 11 10 AM 1963
 OLLIE FARNSWORTH
 R. M. C.

I hereby certify that on July 9, 1963 I surveyed lot according to a plat of Peace Haven section 2 by W. N. Willis dated May 16, 1961 and recorded in plat book "VV" on page 82 in the R. M. C. Office of Greenville County; and that no walls or buildings encroach on adjacent streets or property and no buildings or walls encroach or project on these premises.

Charles F. Webb
 Charles F. Webb R.L.S. 1577

PROPERTY
 of
JAMES A. & VIVIAN N. SULLIVAN
 PEACE HAVEN - SECTION II
 GREENVILLE COUNTY, S. C.
 WEBB SURVEYING & MAPPING CO.
 SCALE 1" = 30' JULY 10, 1963

DD - 145