



AUG 27 1963 ✓


FILED
GREENVILLE CO. S.C.

AUG 27 3 09 PM 1963

R.M.C.

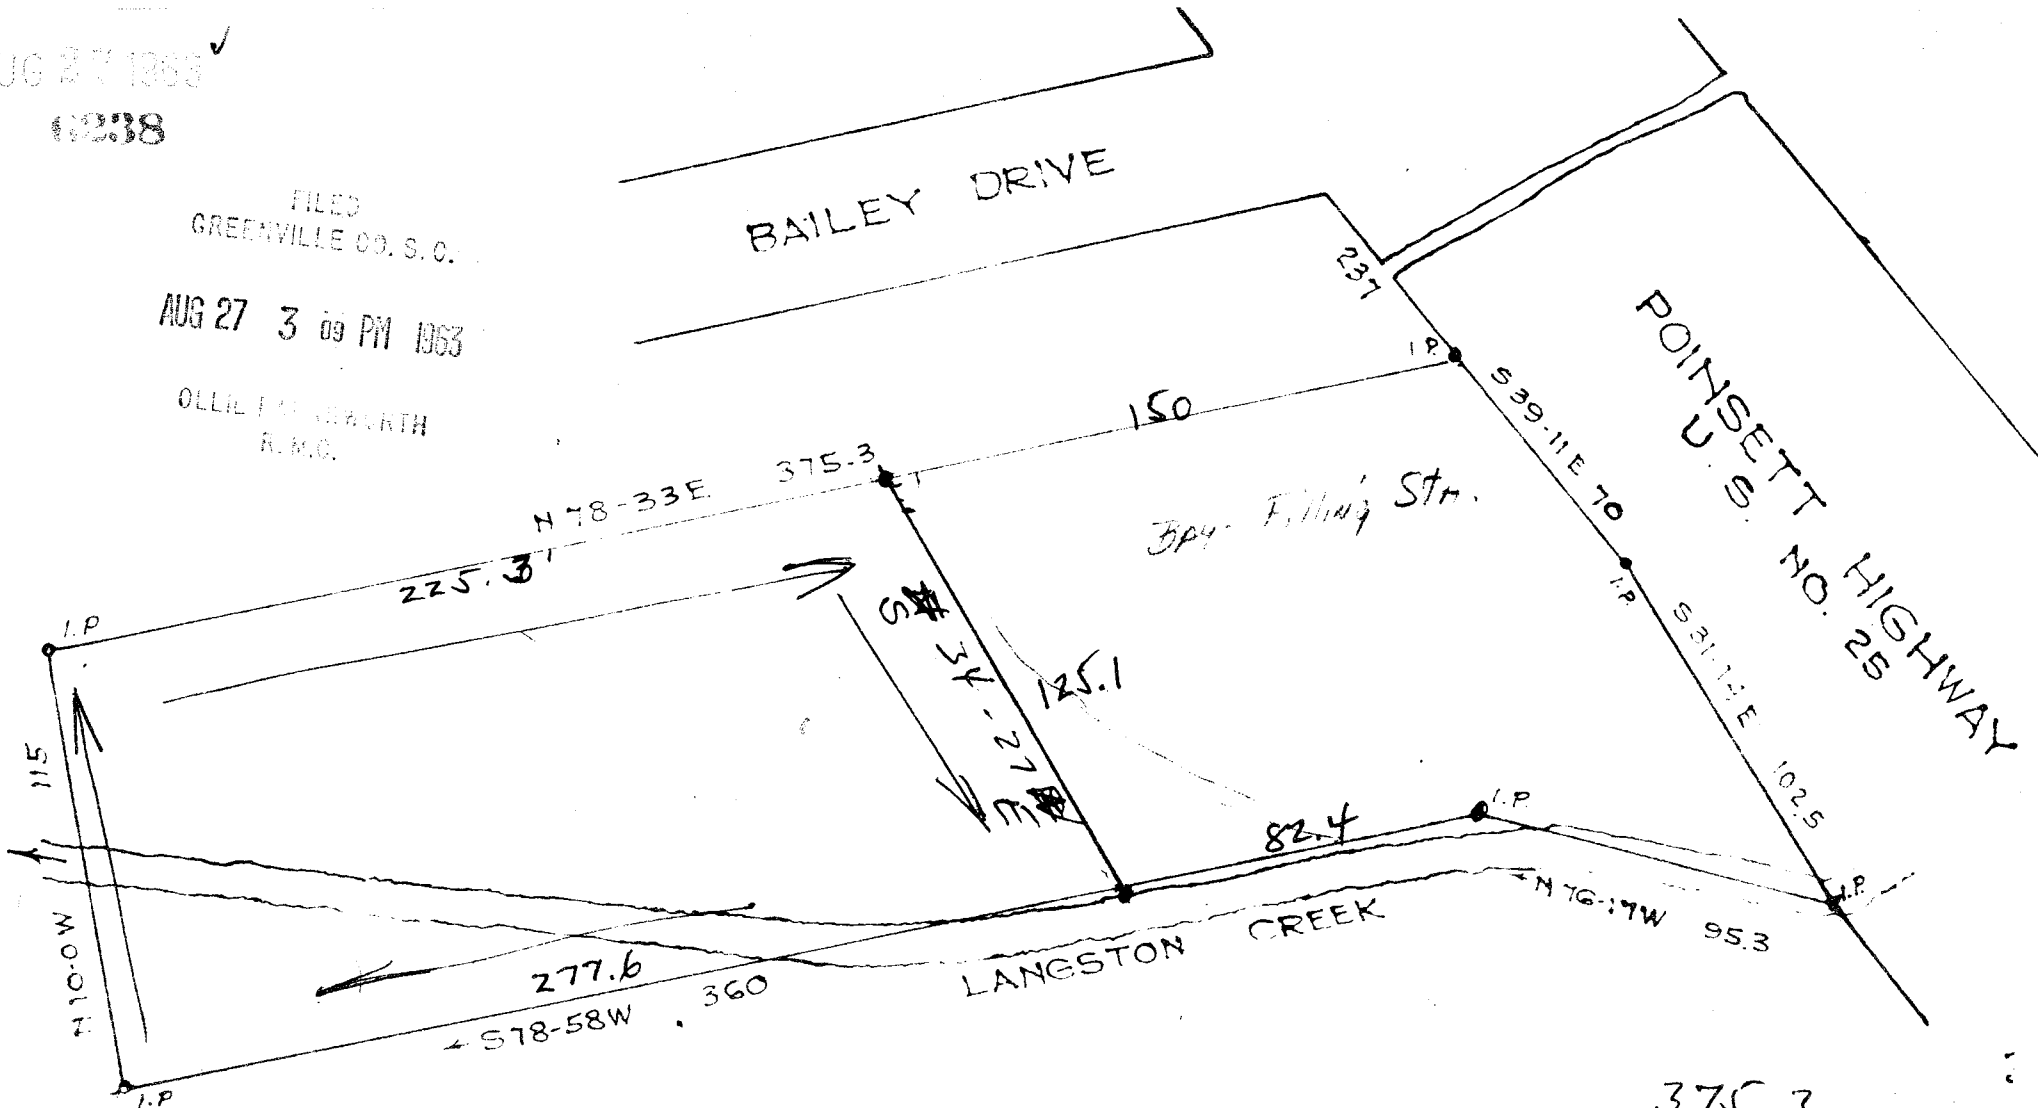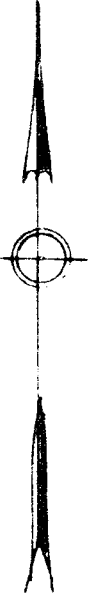

PROPERTY OF

~~OLLIE M. WEBSTER~~

CHARLES E. ROBINSON JR.

WILLIAM M. WEBSTER III

NEAR GREENVILLE S.C.

Scale 1"=50' Feb., 1960

DALTON & NEVES

375.3
150
225.3

6238
41
JUL 183 3:07 PM
Aug. 63

OLLIE M. WEBSTER

DDD - 183