


N.B. NEW ROAD IS ON LOT NO 30
SHADED AREA ADDED TO LOT NO 19

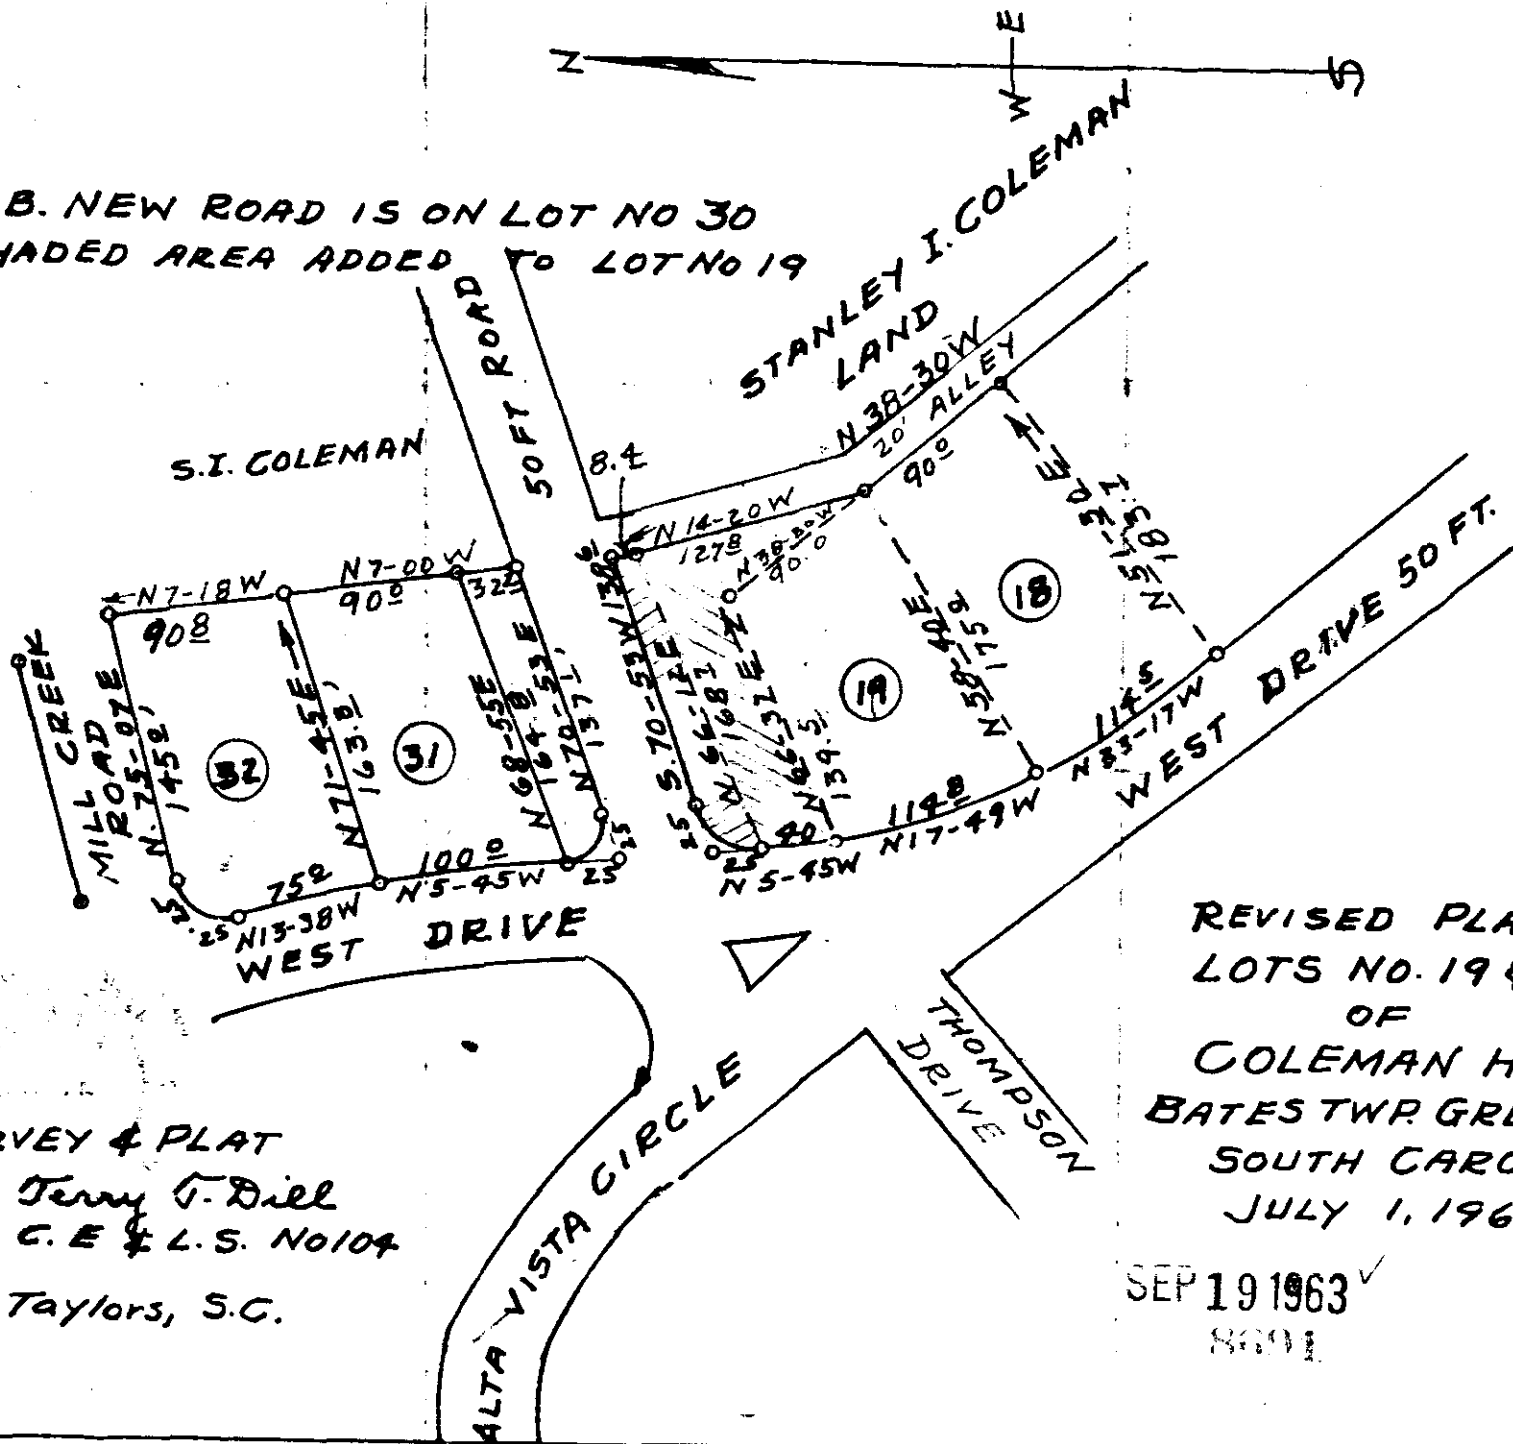

SEP 19 4 22 PM 1963
Ollie Farnsworth
R.M.C.

REVISED PLAT OF
LOTS NO. 19 & NO 30
OF
COLEMAN HEIGHTS
BATES TWP. GREENVILLE CO
SOUTH CAROLINA
JULY 1, 1963

SEP 19 1963
8691

SURVEY & PLAT
BY Terry G. Dill
Reg C. E & L. S. No 104
R#2 Taylors, S.C.

#8691 1963
Sept. 19 63
Recorded to Vol DDD 197 4:22 P.
Ollie Farnsworth
Register No.

17 - Sec 309