


17799

DEC 20 9 17 AM 1963

OLIVER L. BARNWORTH  
R.M.C.

N8152

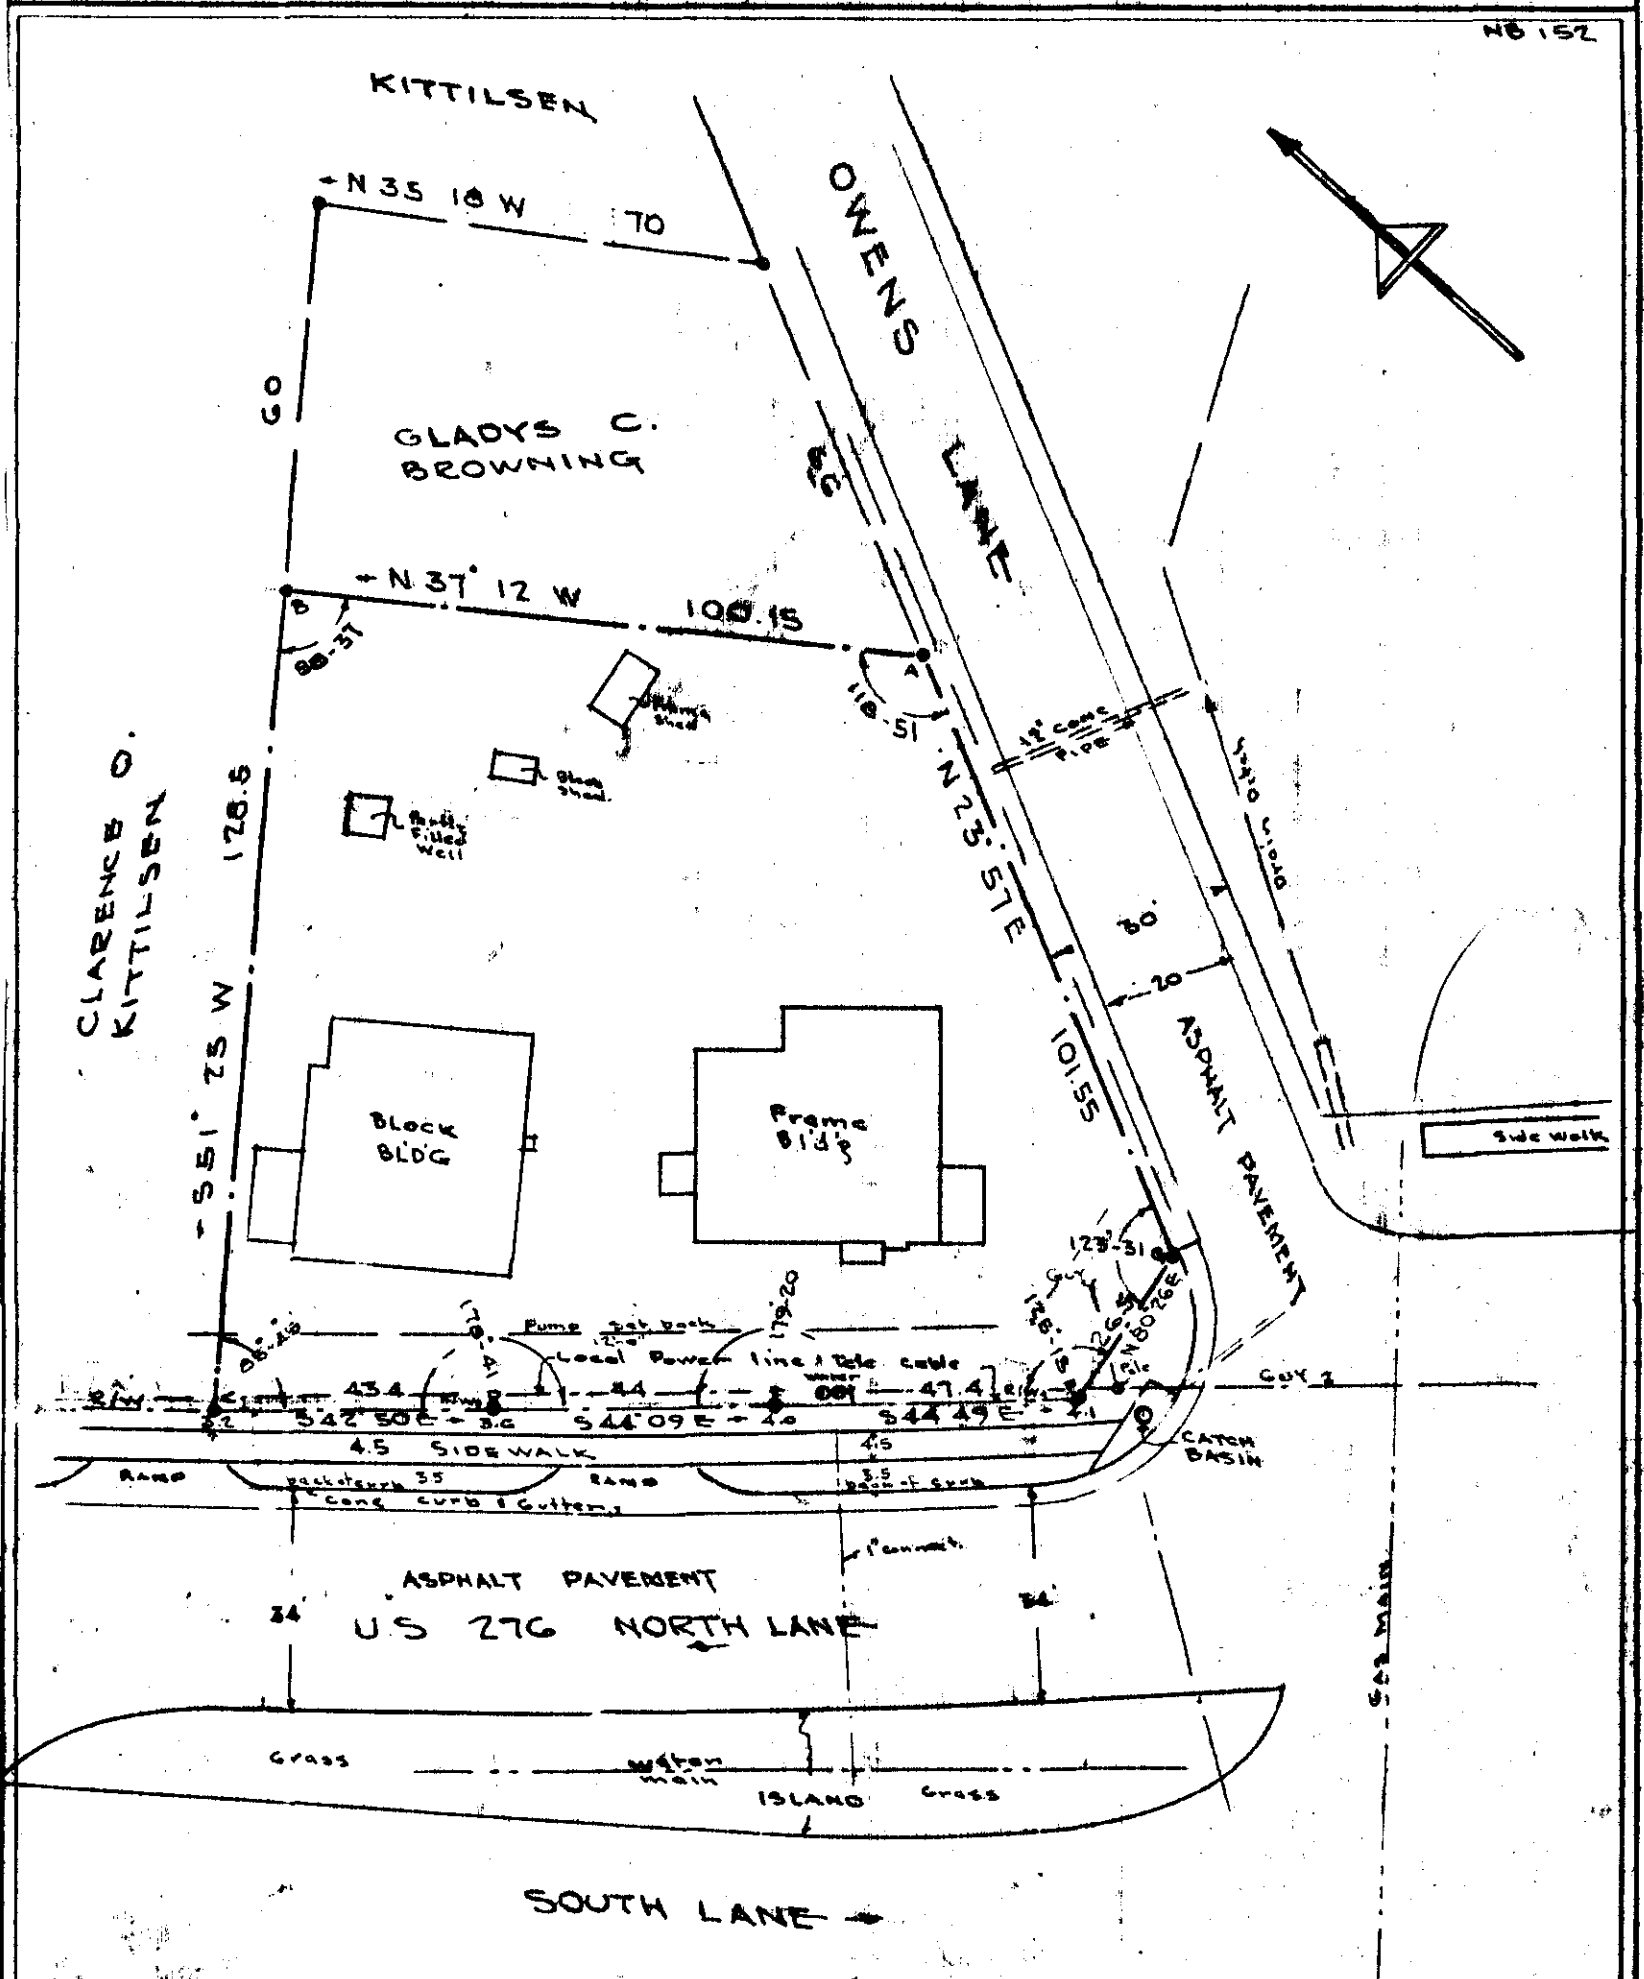

# GULF OIL CORPORATION

U.S. 276 & OWENS ST

MAULDIN

GREENVILLE COUNTY, S.C.

Scale 1" = 30'

JULY 1963

This Plat & Survey is correct as shown.

SS-26068

SC-1144

JONES ENGINEERING SERVICES.

FFF - 3 See 504

17799 Filed This 20 day of Dec 19 63

And Recorded in Vol. FFF Page 3 at 9:17 AM

*Oliver L. Barnworth*  
Register Mesne Conveyance Greenville County, S. C.