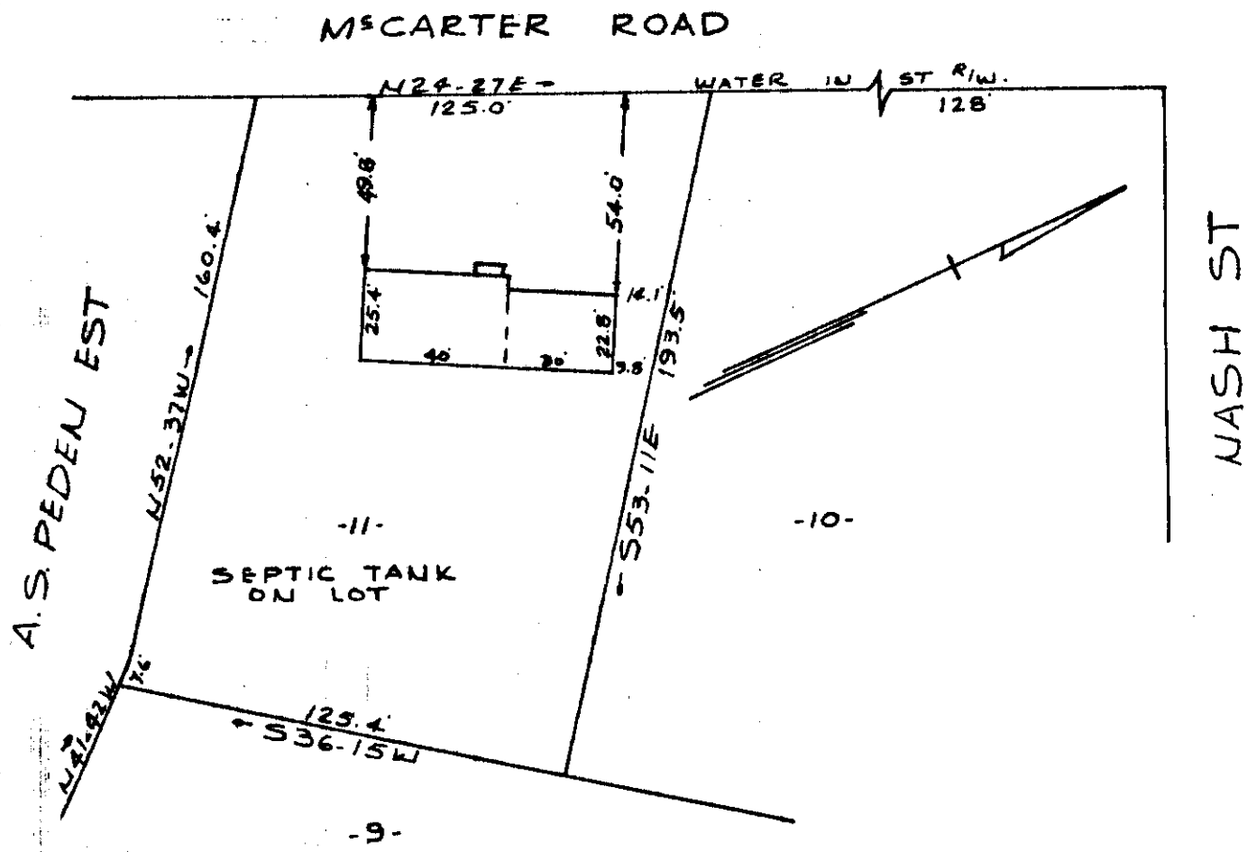

PROPERTY OF
HAROLD R. & RUTH C. MORRIS
FOUNTAIN INN, S.C.
SCALE 1" = 50' 8 APRIL 1964

This is to certify that on the 8th day of April 1964, I surveyed the property shown on this plat, being known as lot 11 and being known as property of L.F. Armstrong property and recorded in the R.M.C. Office Greenville County, S.C. in deed book 600 page 23, and also being known as property of Harold R. & Ruth C. Morris and recorded in the R.M.C. in plat book page ; amd that the property lines, walls and buildings are as shown hereon, and that the buildings located on said lot do not encroach or project on adjacent street or property, and that no adjacent buildings or walls encroach or project on said premises.

FILED GREENVILLE CO. S.C.
APR 10 5 03 PM '64
ELLIE FARNSWORTH R.M.C.

R. B. Bruce.
R.B.Bruce R.L.S. # 1952.

28967

APR 10 1964

FIF — 97

28967 Filed This 10 day of April 19 64
And Recorded in Vol. 555 Page 97 at 5:03 PM
Ellie Farnsworth
Register Mesne Conveyance Greenville County, S. C.