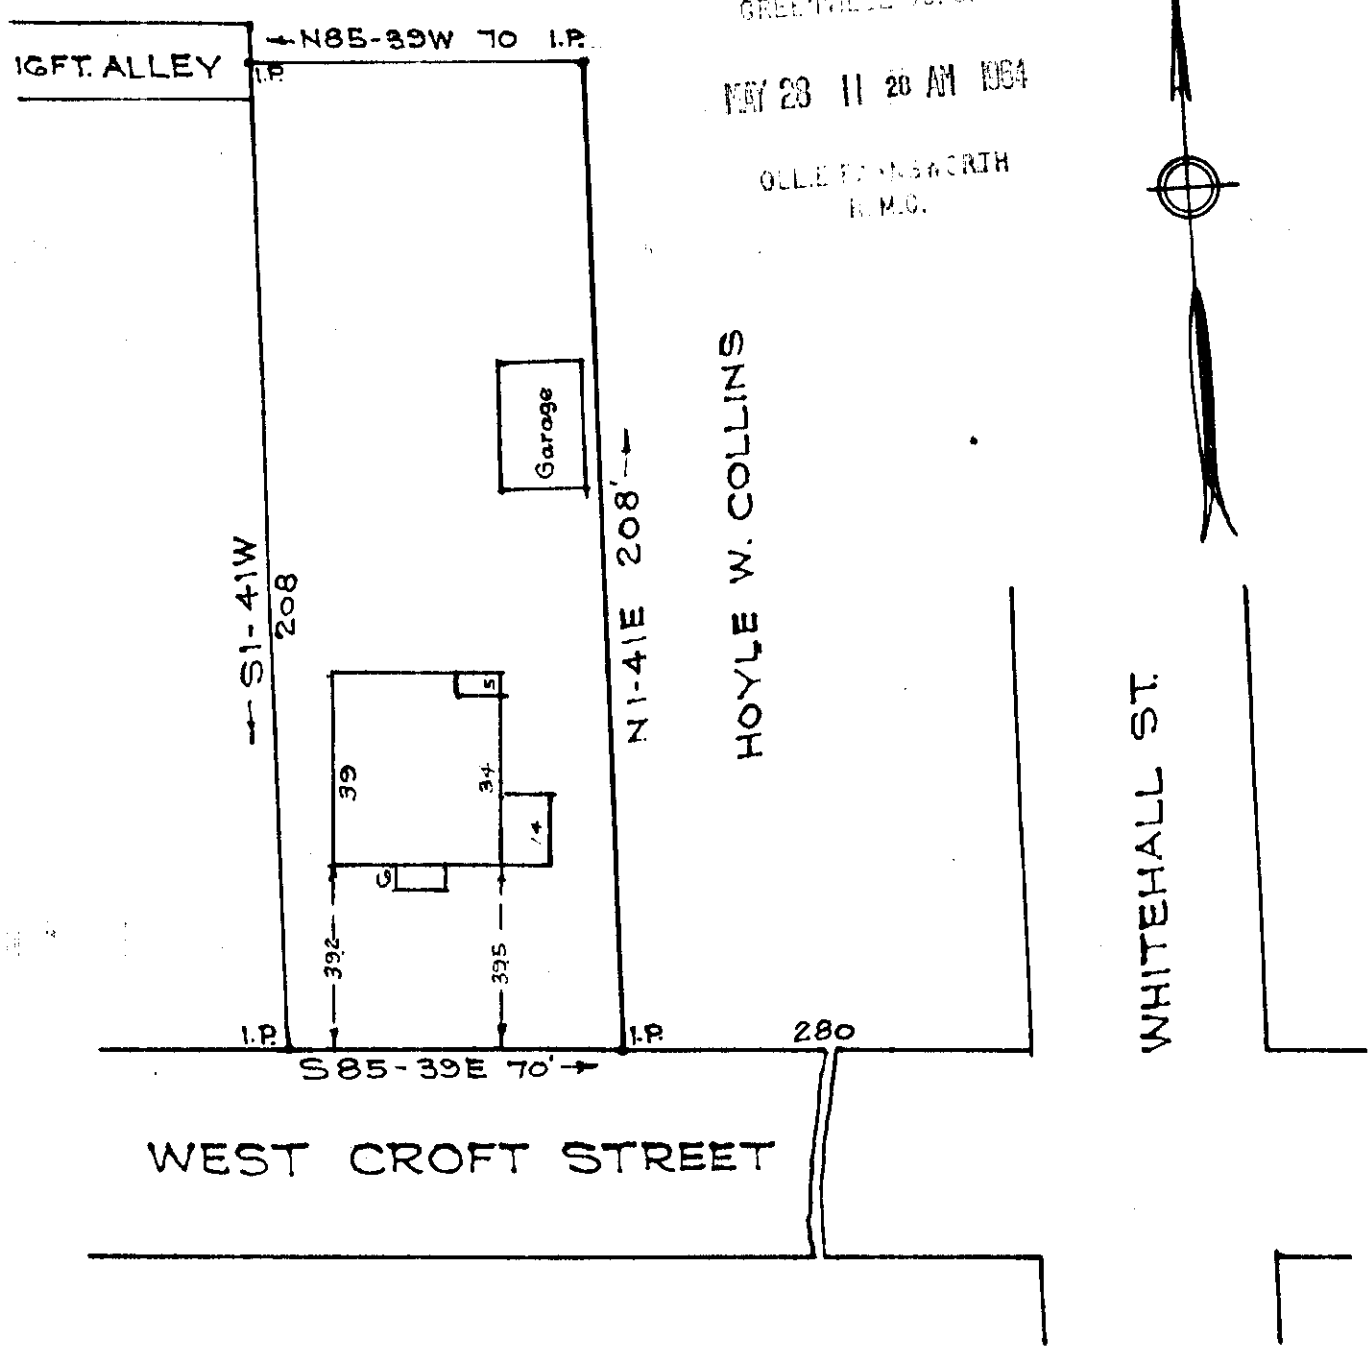

FILED
GREENVILLE CO. S. C.
MAY 28 11 28 AM 1964
OLLIE FARNSWORTH
R. M.C.

PROPERTY OF
JOHN H. DYAR
MILDRED S. DYAR
GREENVILLE S. C.

Scale 1"=40' April 1964

This is to certify that on the 30th day of April, 1964, I surveyed the property shown on this plat; being known as property shown on plat of John H. Dyar and Mildred S. Dyar Recorded in Plat Book FFF page 111, Office of R. M. C. Greenville Co., S. C.; and that the property lines, walls and buildings are as shown hereon; that the buildings located on said property do not encroach or project on adjacent streets or property; and that no adjacent buildings or walls encroach or project on said premises.

R. W. Dalton

DALTON & NEVES, ENGINEERS.

MAY 28 1964
33736

364

FFF-111

50¢

Recorded May 28, 1964 at 11:28 A.M.

Ollie Farnsworth

111