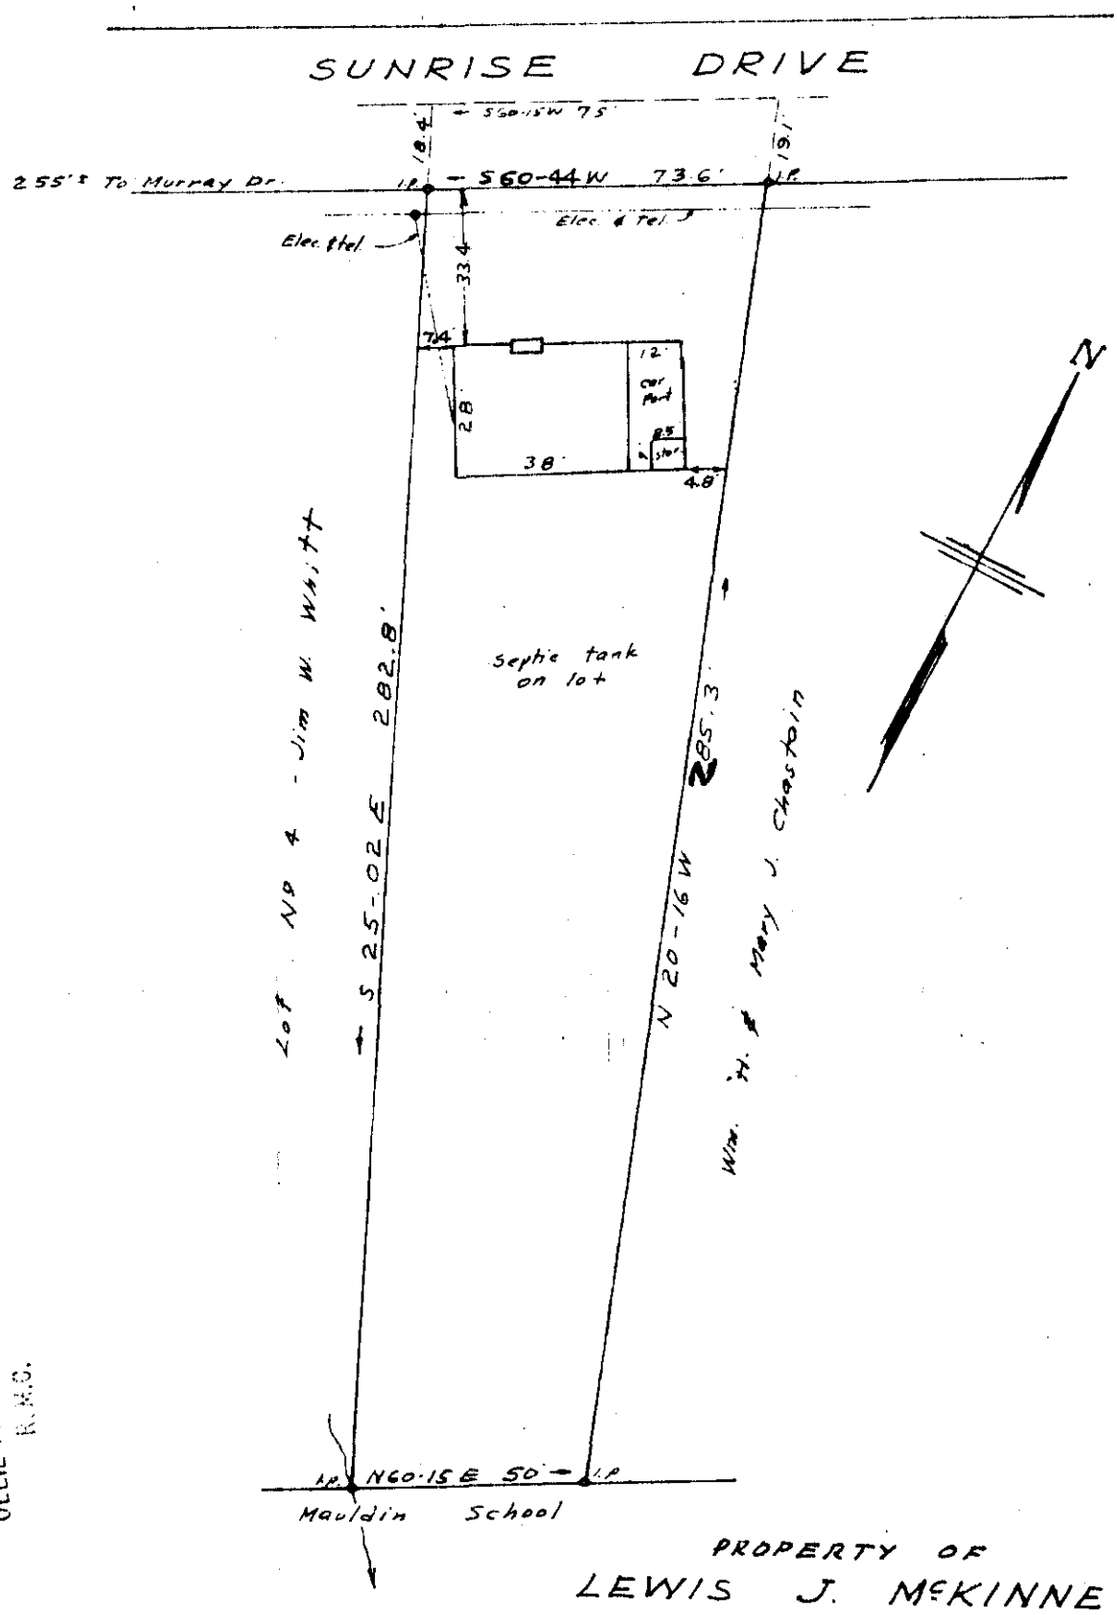

PROPERTY OF
LEWIS J. McKINNEY
MAULDIN S. C.
SCALE 1" = 40' MAR. 16, 1965

This is to certify that on the 16th day of March, 1965, I surveyed the above lot shown on plat of Lewis J. McKinney Property, recorded in plat book III at page 49, and that the property lines, walls and buildings are as shown hereon; andthat the buildings located hereon do not encroach on adjacent streets or property; and that no adjacent buildings, walls or power lines encroach or project on said premises except as shown.

999 - 79 MAR 18 1965 25993

C.O. Riddle - Reg. L.S. #1349

MAR 18 10 49 AM 1965
OLLIE FARNSWORTH
R.M.C.

25993 Filed This 18 day of Mar 19 65
And Recorded in Vol. III Page 49 at 10:49 A.M.
Ollie Farnsworth
Register Mesne Conveyance Greenville County, S. C.