


FILE CO. S. C.  
 APR 27 2 29 PM 1965  
 OLLIE F. SANDWORTH  
 R. M. D.

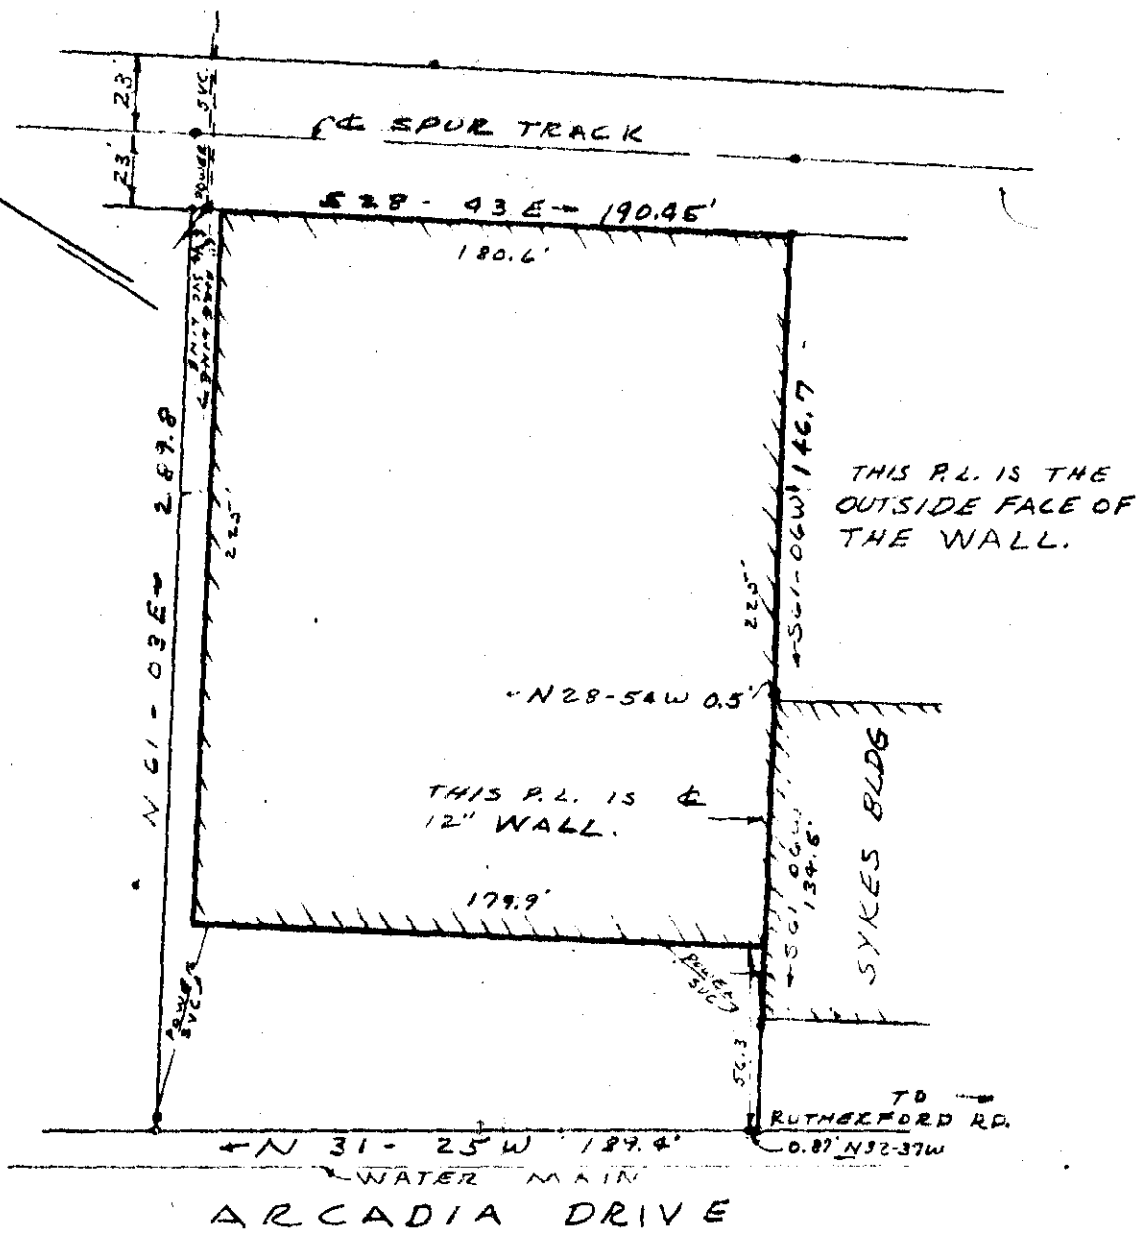

This is to certify that on April 19, 1965, I surveyed the property shown on this plat, and that the property lines, walls and building are as shown hereon, that the building located on said property does not project nor encroach on adjacent streets or property except as shown hereon, and that no adjacent walls or buildings project nor encroach on said premises, and that no utility lines cross this property except as shown hereon.

Survey by AC Chapman  
 S.C.R.L.S. No. 2589

APR 19 1965  
 29941 1/2

PROPERTY OF  
PATEWOOD CORPORATION  
NEAR GREENVILLE, S.C.

APRIL 19, 1965 SCALE 1" = 60'  
 50

III - 107

29941 1/2 Filed This 27 day of April 19 65  
 And Recorded in Vol. III Page 107 at 2:29 P.M.  
Oliver Sandworth  
 Register Mesne Conveyance Greenville County, S. C.