Plat Book MMM. Page 83A

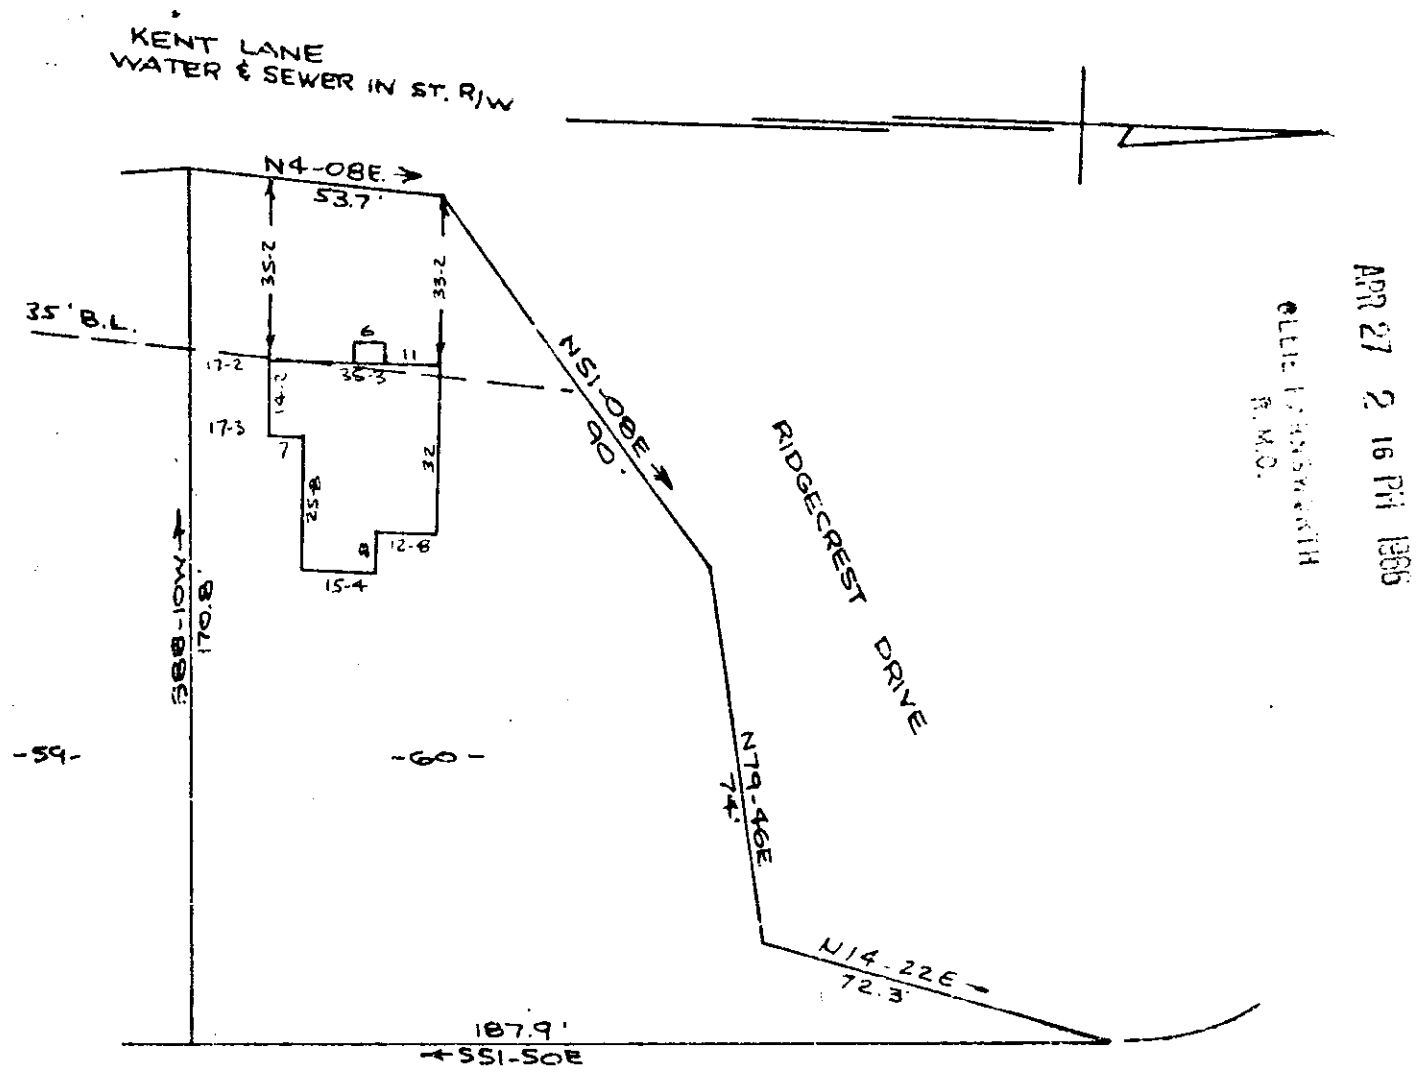

PROPERTY OF

ERVIN S. JOHNSON & MATTIE LEE JOHNSON

GREENVILLE, S.C.

SCALE 1"=40' 18APR1966

This is to certify that on the 18th day of April, 1966 I surveyed the property shown on this plat, being known as lot 60 on plat of VISTA HILLS, and recorded in the R.M.C. Office Greenville County, S.C. in plat book "P" page 39, and also being known as the property of Ervin S. Johnson and Mattie Lee Johnson and recorded in the R.M.C. Office in plat book page ; and that the property lines, walls and buildings are as shown hereon, and that the buildings located on said property do not encroach or project on adjacent street or property, and that no adjacent buildings or walls encroach or project on said premises.

R. B. Bruce

R. B. Bruce R.L.S. # 1952

CAROLINA ENGINEERING AND SURVEYING CO.
GREENVILLE, S.C.

30890

MMM-83 Fee 50¢

30890 Filed This 27 day of April 19 66

And Recorded in Vol. MMM Page 83 at 3:16 PM

Ellie Farnsworth

Register Mesne Conveyance Greenville County, S. C.