


000
114

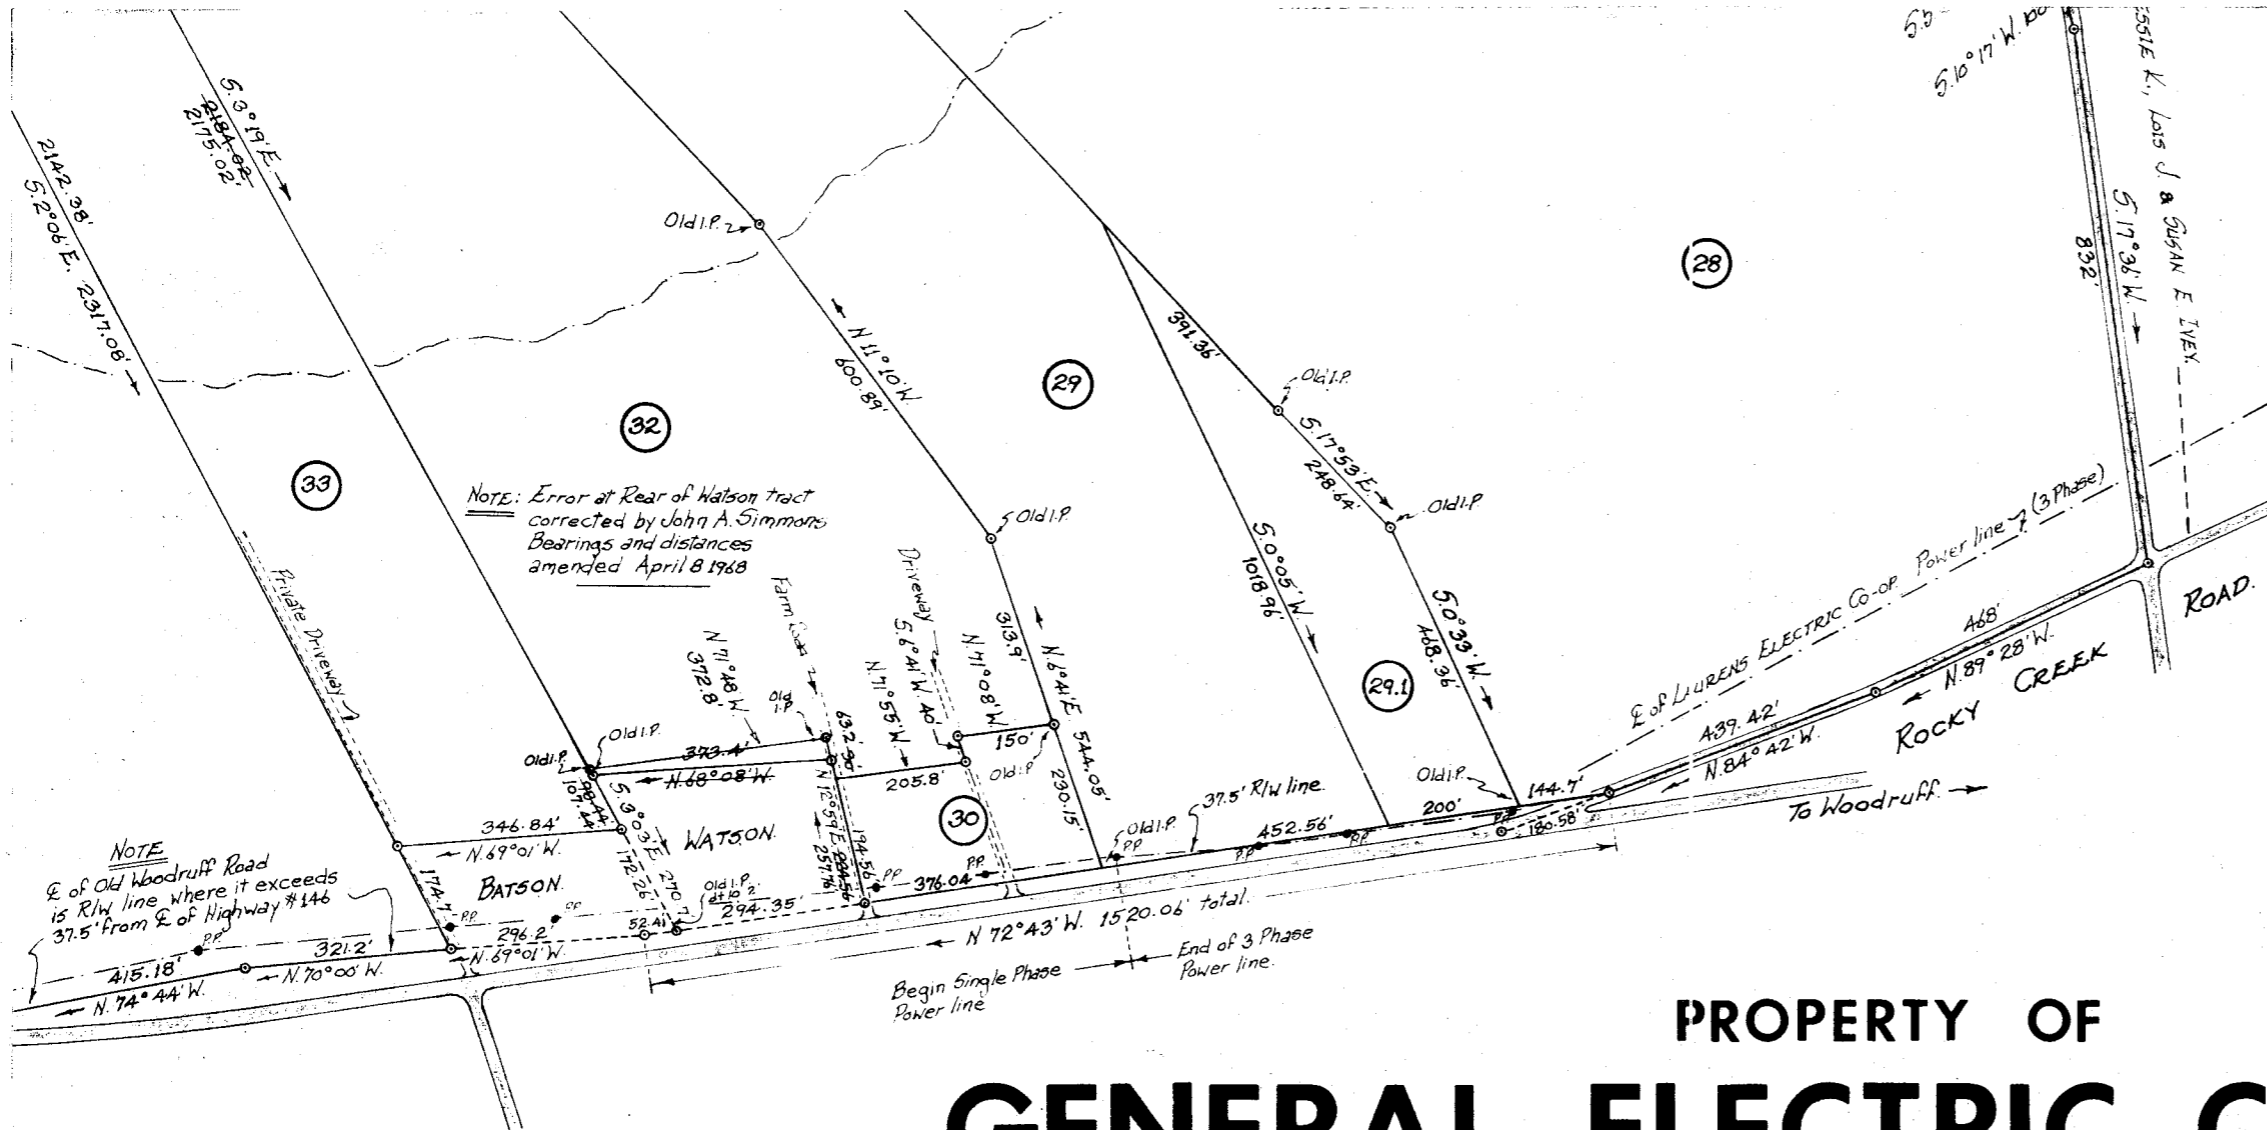


Tract #1	64.354 Acres
" #17	146.861 "
" #28	68.763 "
" #29	25.996 "
" #29.1	3.300 "
" #30	1.737 "
" #32	38.588 "
" #33	15.000 "
" #34	55.686 "
" #36	161.067 "
" #20	4.437 "
" #19	20.695 "
" #22.1	5.120 "
" #21	1.848 "
TOTAL AREA =	614.298 ACRES
	125

PROPERTY OF GENERAL ELECTRIC COMPANY

Located approximately 7 miles East of City of Greenville

GREENVILLE COUNTY SOUTH CAROLINA

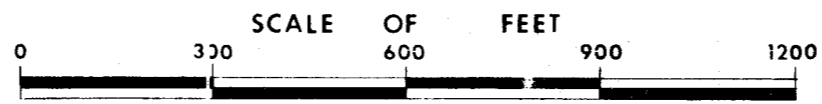

JUNE 19 1967

JOHN A. SIMMONS Registered Surveyor #2212
GREER, S.C.

GREENVILLE CO. S.C.
APR 22 11 30 AM 1968
G.L.E. # 27424

000-114
\$ 1.00

APR 22 1968

27424

#27424 Filed This 22 day of April 1968
And Recorded in Vol. 000 Page 114 of 11:39 P.
Ollie Thomas
Register Means Conveyance Greenville County, S. C.