FILED
GREENVILLE CO. S.C.

APR 19 10 29 AM 1967

OLIVE S. FARNSWORTH
R.M.C.

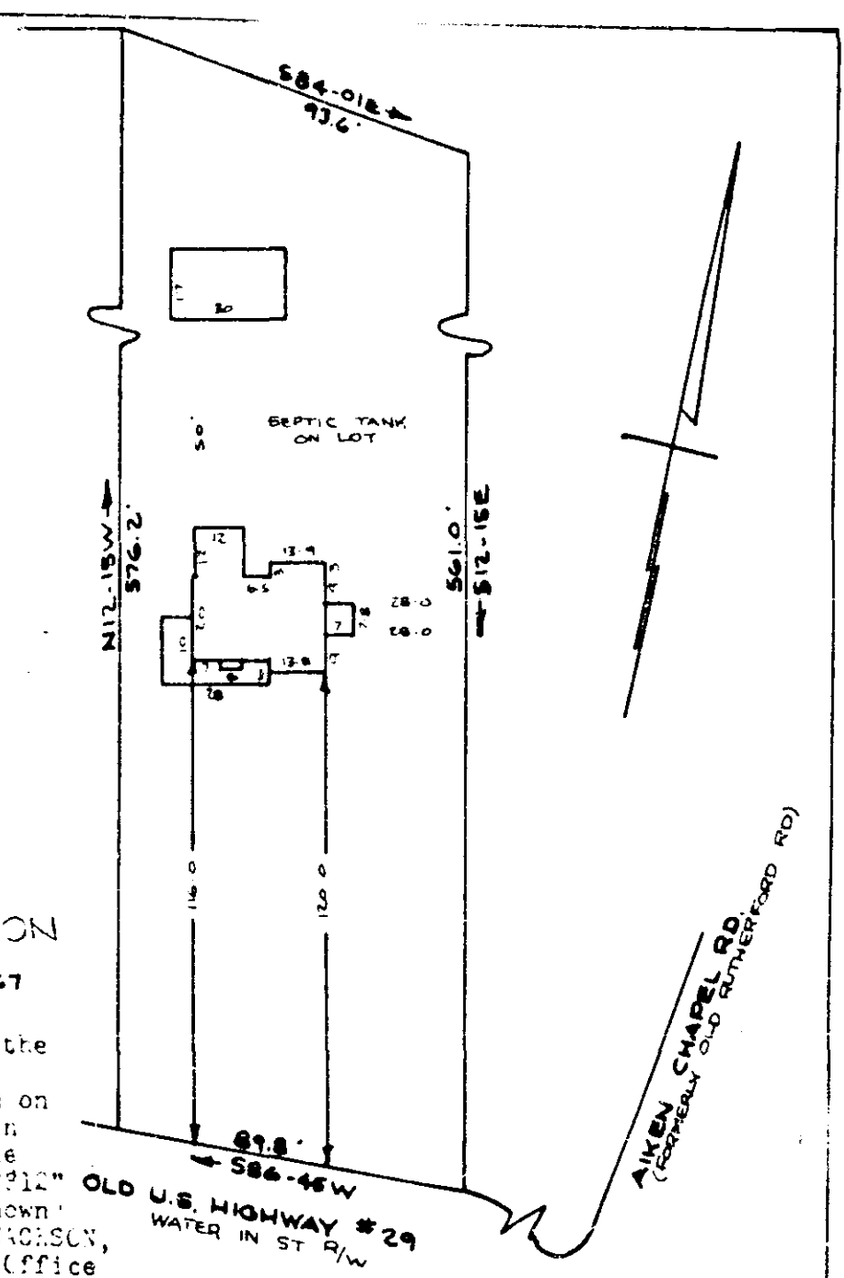


PROPERTY OF
WILLIAM E. JACKSON
TAYLORS, S. C.
SCALE 1"=40' 20 MAR 1967

This is to certify that on the 20th day of March, 1967, I surveyed the property shown on this plat, being recorded in the R.M.C. Office Greenville County, S.C. in Deed book "912" page 346, and also being known as property of WILLIAM E. JACKSON, and recorded in the R.M.C. Office in plat book page ; and that the property lines, walls and buildings are as shown hereon, and that the buildings located on said lot do not encroach or project on adjacent street or property, and that no adjacent buildings or walls encroach or project on said premises.

R. B. Bruce
R. B. Bruce R.L.S. # 1772

CAROLINA ENGINEERING AND SURVEYING COMPANY
GREENVILLE, S.C.

Sec 50'
R.R.R. - 21 25180

#25180 Filed This 18 day of April 19 67
And Recorded In Vol. R.R.R. Page 21 at 10:30 A.
Olive Farnsworth
Register Mesne Conveyance Greenville County, S. C.