PLAT BOOK RRR page 49

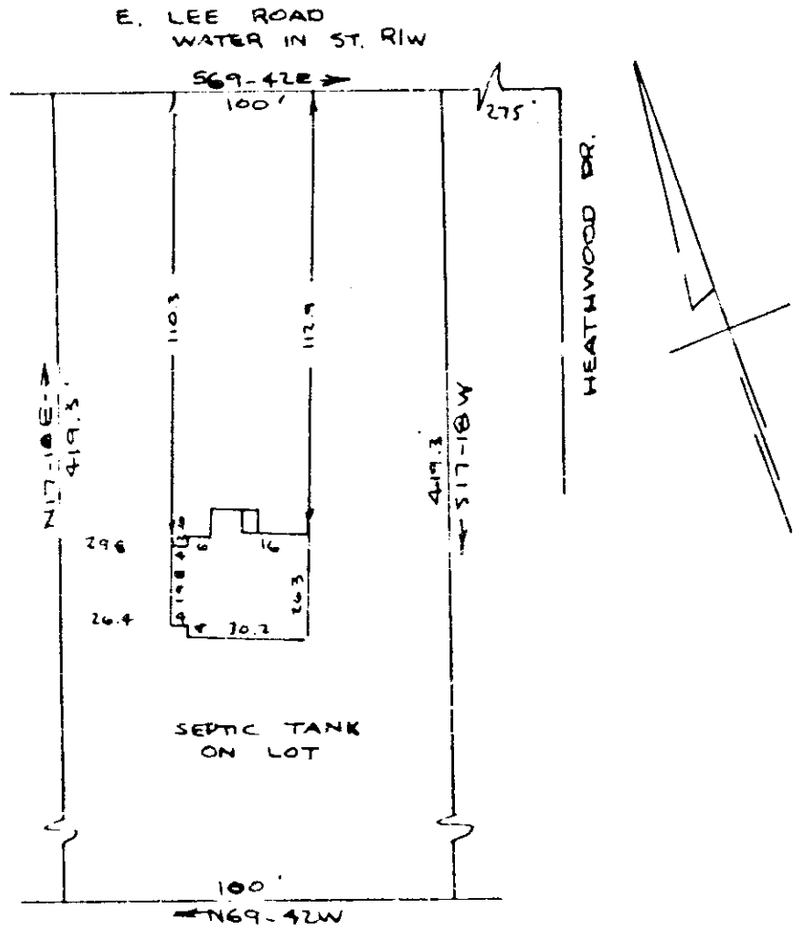

PROPERTY OF
DAN T. SUDDETH & MARY BILL M. SUDDETH
NEAR GREENVILLE, S. C.
SCALE 1"=40' 14 JULY 1967

This is to certify that on the 14th day of July, 1967, I surveyed the property shown on this plat, being known as Property of JOHN H. TAYLOR, JR., and recorded in the R.M.C. Office Greenville County, S.C., in deed book "799" page 340; and also being known as property of DAN T. SUDDETH & MARY BILL M. SUDDETH, and recorded in the R.M.C. Office in plat book RRR page 49 ; and that the property lines, walls and buildings are as shown hereon, and that the buildings located on said lot do not encroach or project on adjacent street or property, and that no adjacent buildings or walls encroach or project on said premises.

R. B. Bruce
R. B. Bruce R.L.S. # 1952

RRR-49
2536

CAROLINA ENGINEERING AND SURVEYING CO.
GREENVILLE, S. C.

50¢

#2536 Filed This 21 day of July 19 67
And Recorded In Vol. RRR Page 49 at 1:06 P. M.
Neil Tarrant
Register Mesne Conveyance Greenville County, S. C.

JUL 21 1 03 PM 1967
OLLIE FAIRCLOTH
R.M.C.

49