PLAT BOOK K PAGE

#6572 Filed This 31 day of Aug. 19 67
And Recorded in Vol. RRR Page 123 at 12:16 P.M.
Olie Farnsworth
Register Mesne Conveyance Greenville County, S. C.

REF: PLAT OF NORTH PARK
FILED IN PL. BK. "K" PAGE 48 + 49

FILED
GREENVILLE CO. S.C.
AUG 31 12 16 PM 1967
CLERK OF COURT
R.M.C.

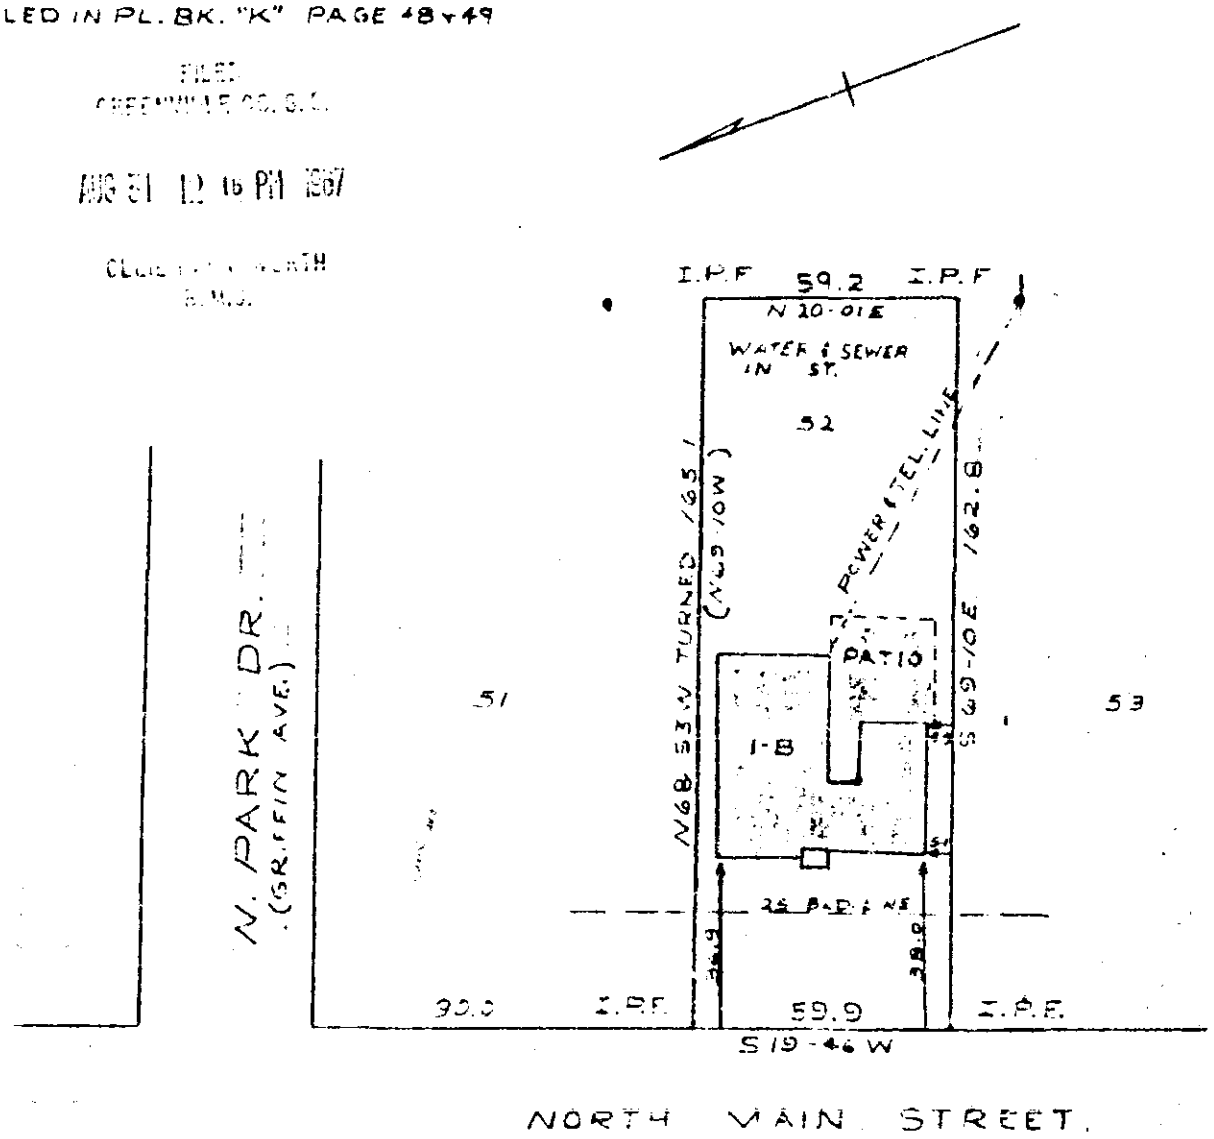

PROPERTY OF
WILLIAM M. GRANT JR & JEANNIE G. GRANT
IN GREENVILLE, SOUTH CAROLINA
SCALE 1" = 40'

This is to certify that on the 15 day of AUGUST 1967, I surveyed the property shown on this plat; and that the property lines, wall and buildings are as shown hereon; that the buildings located on said lot do not encroach or project on adjacent streets or property; and that no adjacent walls or buildings encroach or project on this lot; and that there are no utility lines crossing this property except as shown.

Registered Engineer No. 962

6572

Fee 50¢
G.R.R. - 123

PIEDMONT ENGINEERS AND ARCHITECTS
GREENVILLE, S. C.

123