


8095 Filed This 15th day of Sept. 1967
 And Recorded in Vol. R.R. Page 161 at 3:30 P.
 Ollie Farnsworth
 Register Mesne Conveyance Greenville County, S. C.

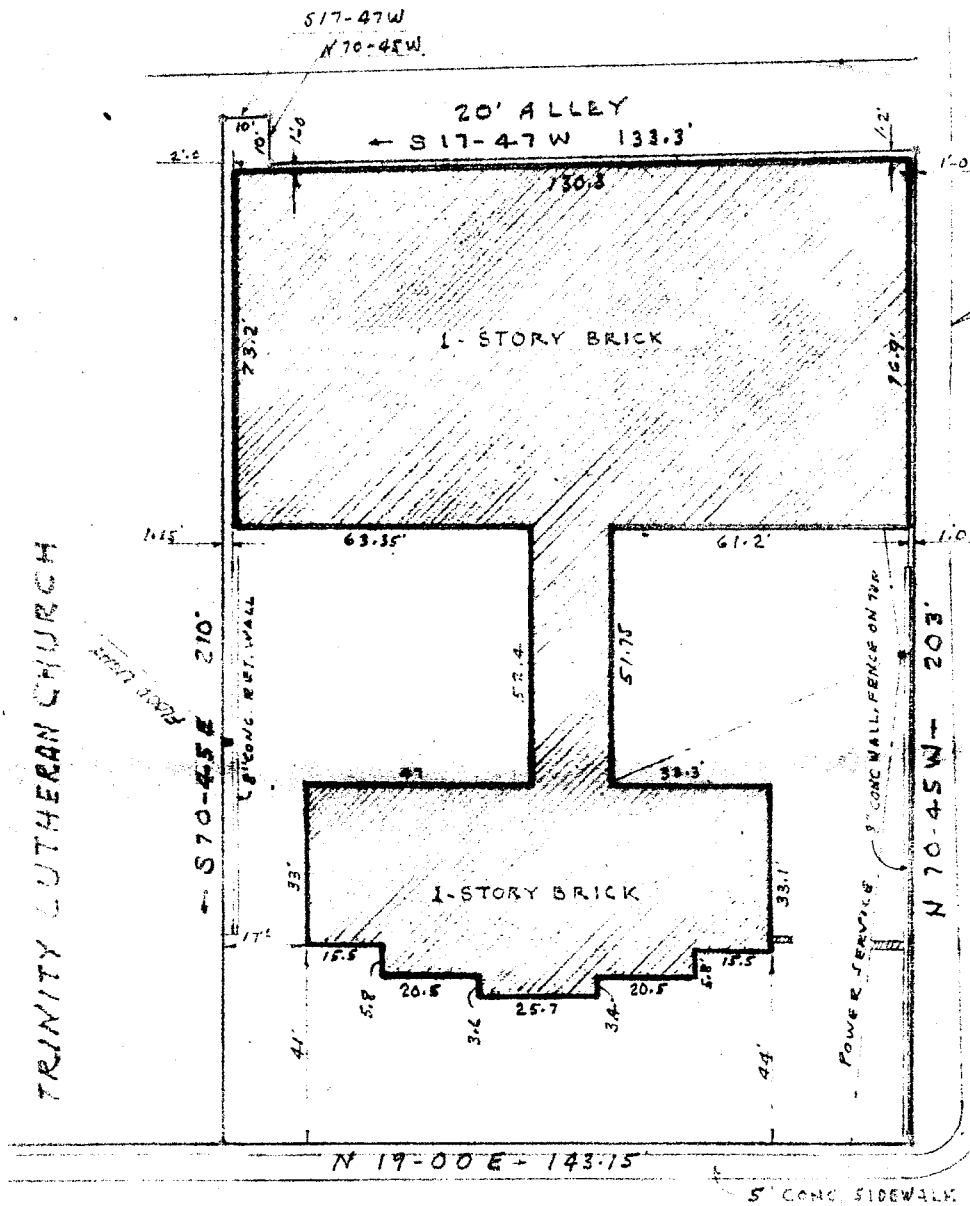

ACADEMY ST. LOOP

SEP 15 3 30 PM 1967

FILED
GREENVILLE CO. S. C.

OLLIE FARNSWORTH
R.M.S.

NORTH MAIN STREET

PROPERTY OF
 T.L. AYER JR., J.F. HARRISON,
 WESLEY HARRISON & J.B. STEPHENS
 GREENVILLE, S.C.
 SCALE 1" = 40' SEPT. 13, 1967

This is to certify that on Sept. 13, 1967 I surveyed the property shown on this plat, shown in City Block Book for Greenville S.C. page 3, Block 2, Lot 24, and that the property lines, walls and building are as shown hereon; that the building located on said lot does not encroach or project on adjacent streets or property, and that no adjacent walls or buildings encroach or project on said premises, and that no utility lines cross this property except as shown hereon.

Surveyed by H.C. Clarkson

Campbell & Clarkson, Reg.

8095

Paste in 50¢ R.R. - 161

161