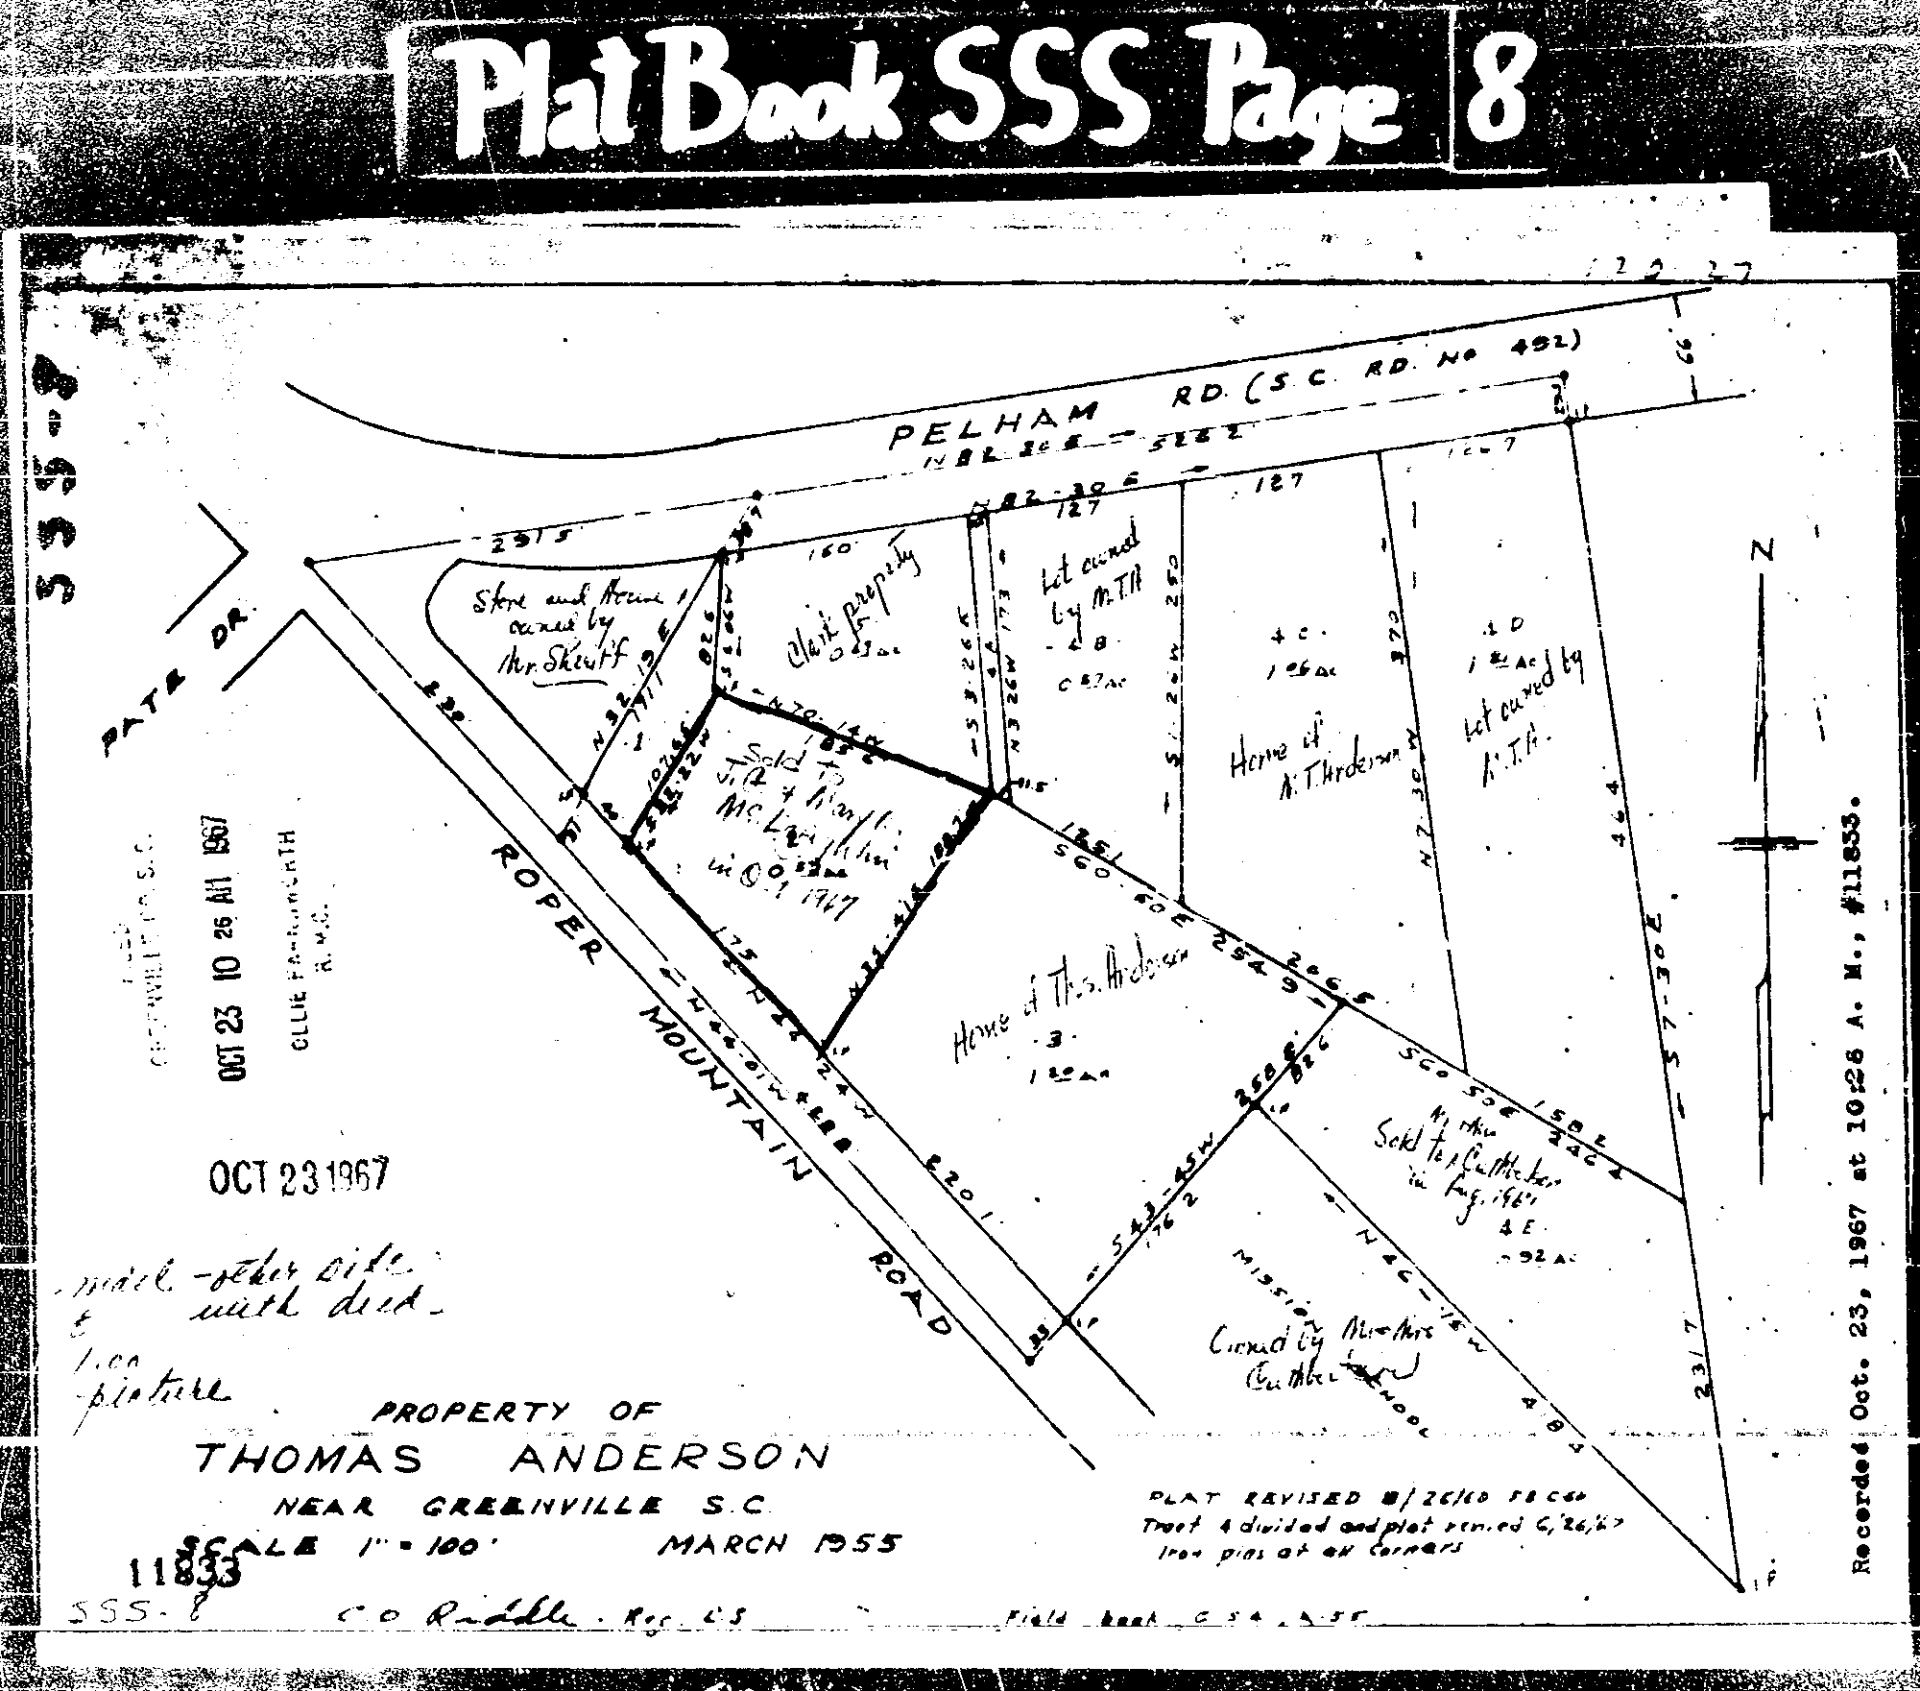Plat Book SSS Page 8