Plat Book 555 Page 86

555-86

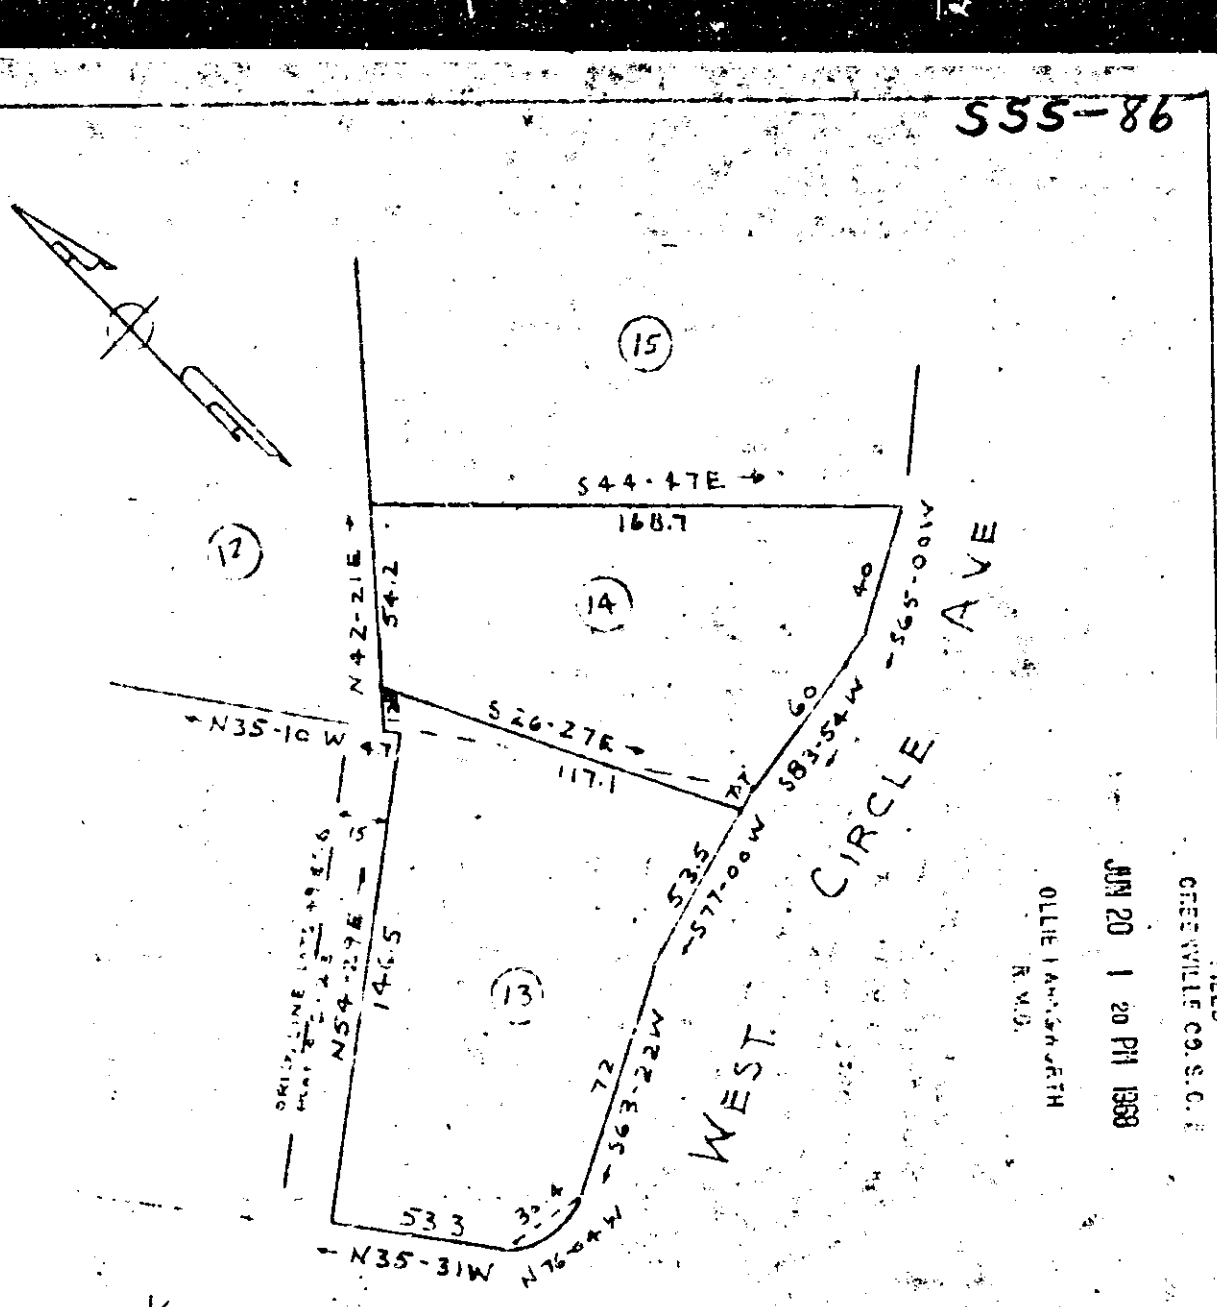

REVISION OF LOTS 13 & 14

KENDALL GREEN SUBDIVISION

GREENVILLE S. C.

WEBB SURVEYING & MAPPING CO

SCALE 1" = 50' MAY 1968

CHARLES F. WEBB
REGISTERED
1577
LAND SURVEYOR
SOUTH CAROLINA

32791

555-86

Plotted 1:00

Recorded June 20, 1968 at 1:20 P. M., #32791.

JUN 20 1 20 PM 1968

GREENVILLE CO. S. C.

OLLIE FARNSWORTH
R.M.C.