Plat Book SSS Page 90

SSS-90

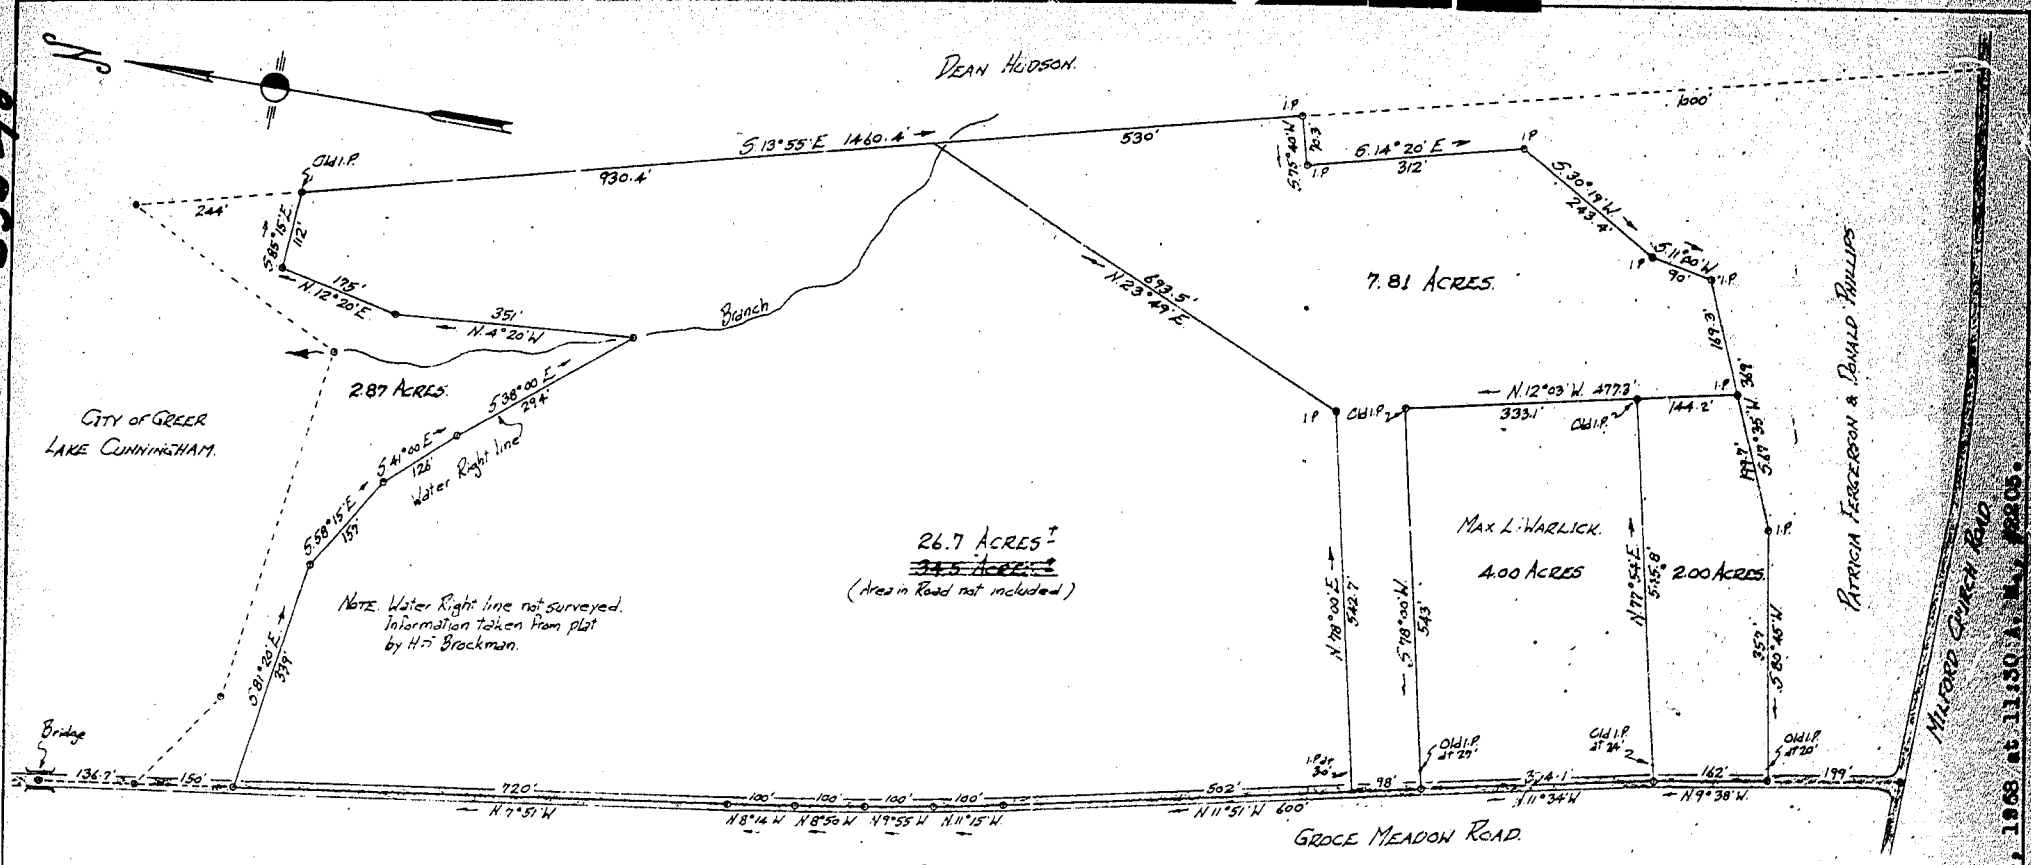

SOUTH CAROLINA
REGISTERED
LAND SURVEYOR
NO. 2212
JOHN A. SIMMONS

A.A.J. - 71

2205

John A. Simmons, Reg. Surveyor # 2212
GREER, S.C.

JUL 25 1968

PROPERTY OF
ROBERT PERRY

Located 2 miles west of Milford Church

ONEAL TOWNSHIP GREENVILLE COUNTY.

SOUTH CAROLINA.

SCALE 1" = 200 FEET. SEPT 23 1967.

Part survey made Sept 22 1967

NOTE: Plat amended April 6 1968 to show 7.81 Acres tract.

NOTE: Information taken from plat of H.E. Hudson property by me Oct 12 1961

Recorded July 25, 1968 at 11:30 A.M. #2205.

Picture 1.00