

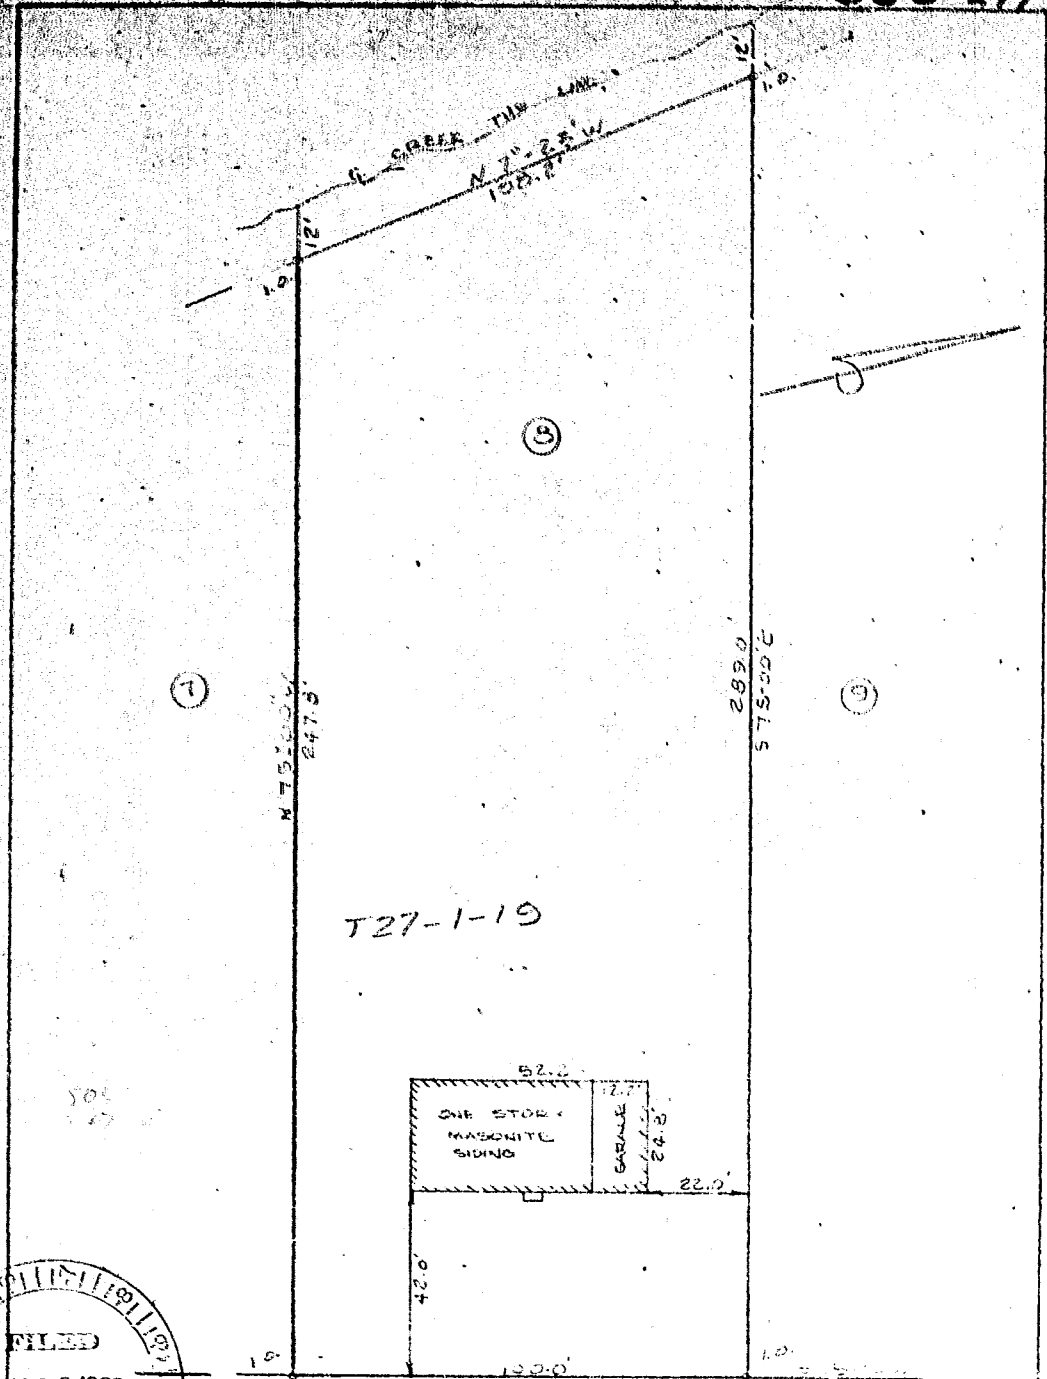


SSS-217

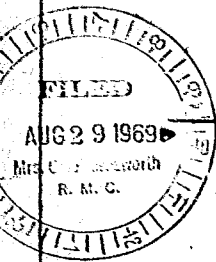

T27-1-19

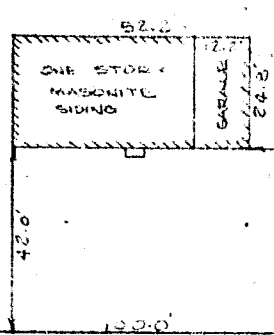

IN REE: COURT

## PLAT PREPARED FOR HENRY SANDERS, JR.

THE SAME BEING SHOWN AS LOT # 8 ON PLAT OF ELOISE HEIGHTON J. MAC RICHARDSON AND RECORDED IN THE R.M.C. OFFICE FOR GREENVILLE COUNTY IN PLAT BOOK "RR." PAGE 63.

NEAR GREENVILLE, S.C.  
 SURVEYED BY:  
 R.E. COLLINGWOOD, JR.

SSS-217

GREENVILLE COUNTY  
 REGISTER OF DEEDS  

I HEREBY CERTIFY THAT THE MEASUREMENTS AS SHOWN ON THIS SURVEYING CORRECTION AND THERE ARE NO ENCROACHMENTS OR PROJECTIONS OTHER THAN SHOWN

5117

*R. E. Collingwood, Jr.*  
 REG. SURVEYOR

1.00 Photo Recorded Aug., 29, 1969 at 9:45 A. M. #5117.