


SSS-241

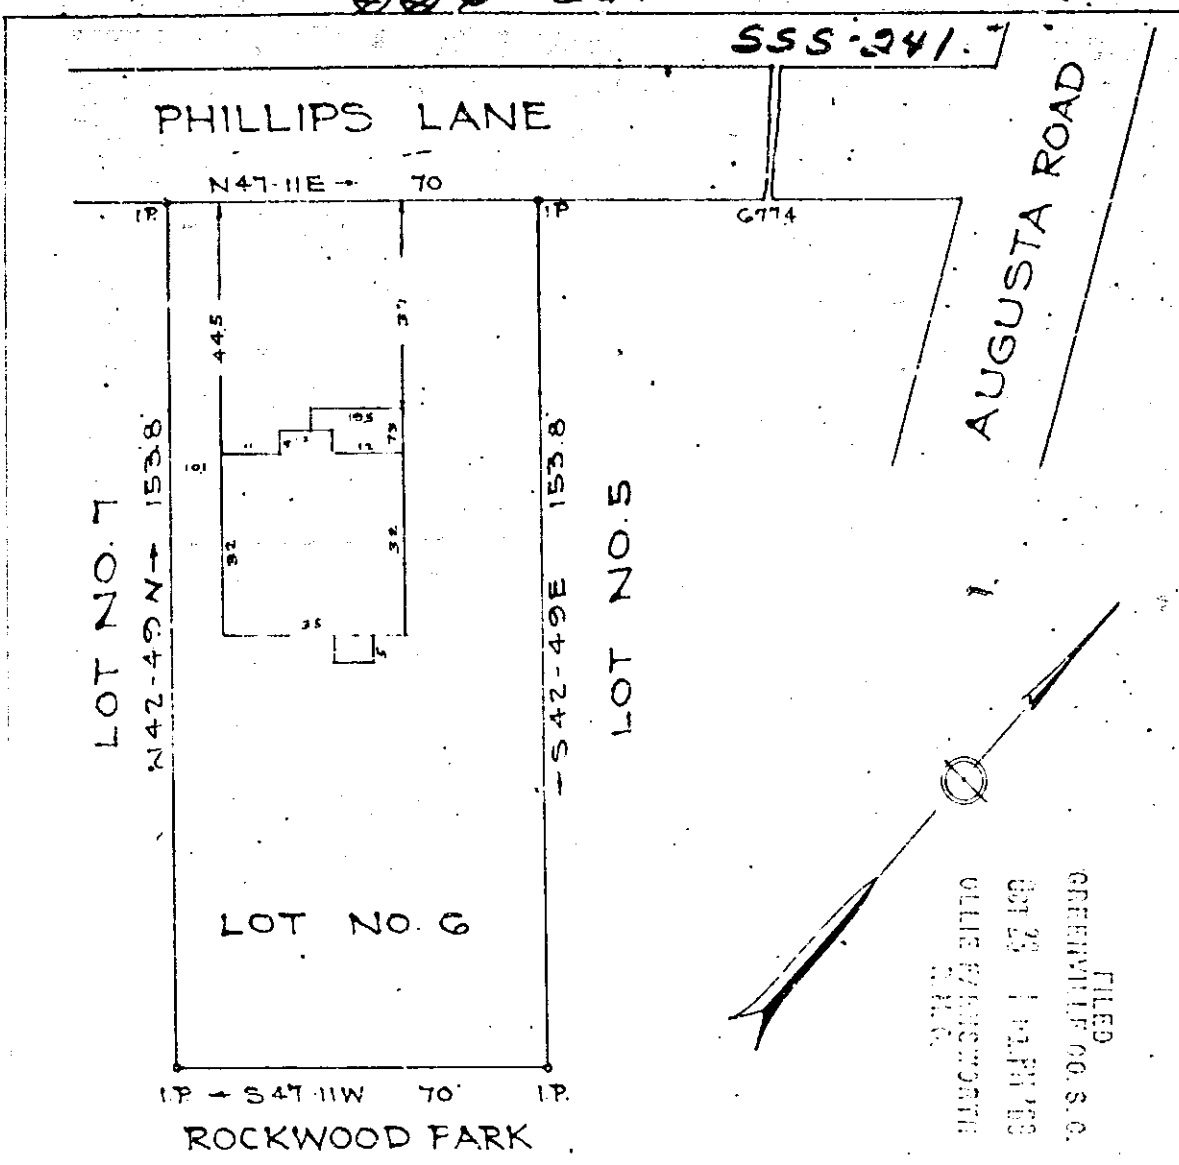

PROPERTY OF
 EDGAR OLIN HORGER JR
 GREENVILLE S.C.
 Scale 1"=30' Nov. 1950

This is to certify that on the 10th day of November, 1950, I surveyed the property shown on this plat; being known as Lot No. 6 on plat of T. F. Huguenin and J. F. Douglas, recorded in Plat Book B page 189, Office of R. H. C. Greenville Co., S. C.; and that the property lines, walls and buildings are as shown hereon; that the buildings located on said lot do not encroach or project on adjacent streets or property; and that no adjacent buildings or walls encroach or project on said premises.

OCT 23 1969

R. W. Walton
 Registered.

9730

Recorded Oct. 23, 1969 at 1:41 P. M., #9730.

Plat to 100
map with
262
Huguenin - 189 - Phillips - 189 - 189