Plat Book SSS Page 385

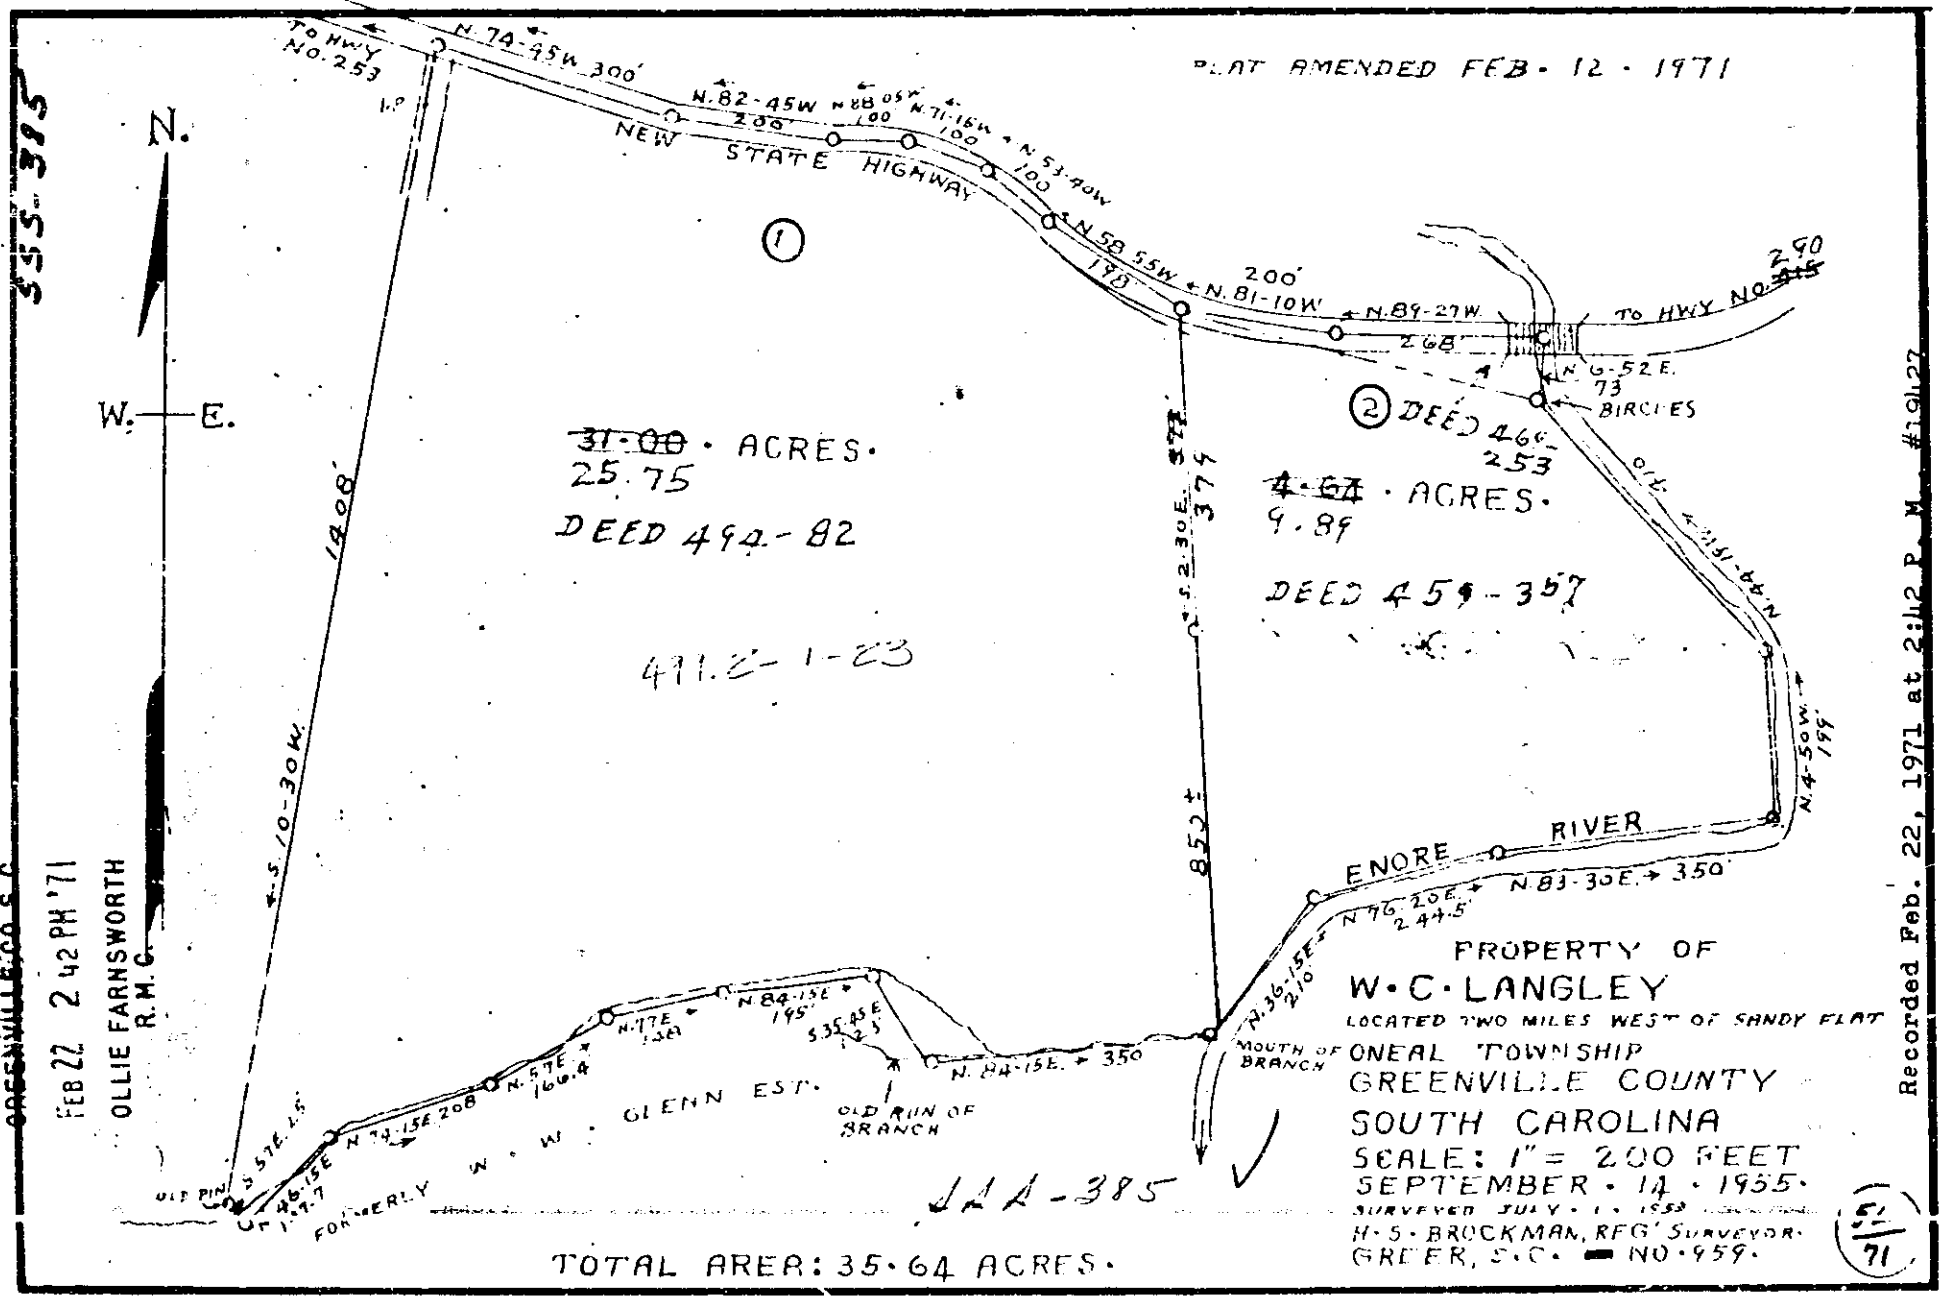

FEB 22 1971 19127