


Plat Book SSS Page 462

SSS-462

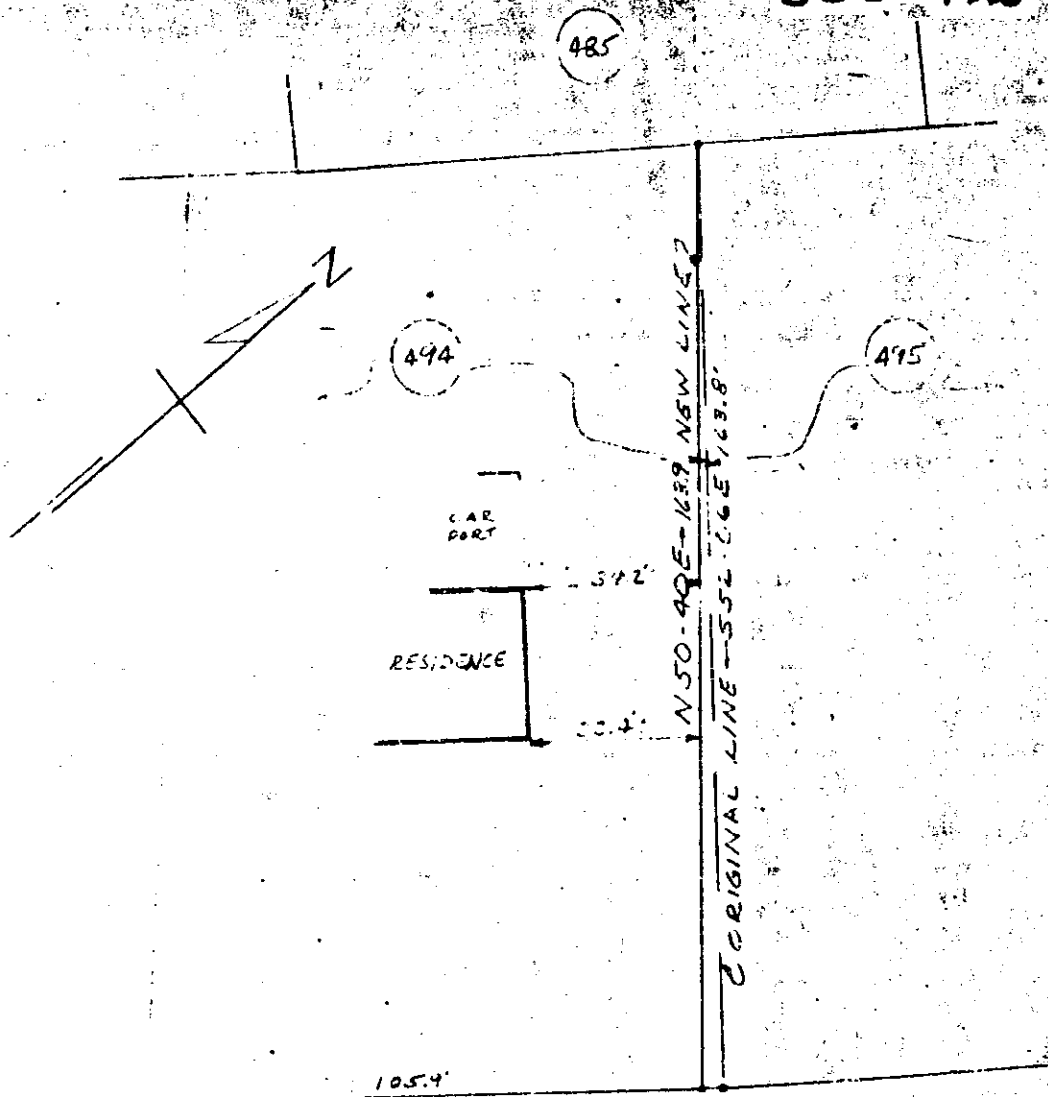

FILED
GREENVILLE CO. S. C.

SEP 11 10 55 AM '71

E. F. FARIS, NORTH
R.M.C.

SHALLOWFORD ROAD

REVISION OF LOTS 494 & 495
SEC. D - GOWER ESTATES
GREENVILLE, S. C.

RECORDING FEE
5.00

MARCH 17, 1967 SCALE 1" = 30'

SSS-462

SURVEY BY: CAMPBELL & CLARKSON
N. C. Clarkson
SCALE N 2589

SEP 14 1971

Recorded Sept. 14, 1971 at 10:55 A. M., #7772.