

555 - 634

185  
Plat to

08

PENNSYLVANIA

AVE.


(36' PAVED)

537' TO S. C. 14

S 83° 00' E →  
60

POWER POLE  
ON CORNER

OLD I.P.

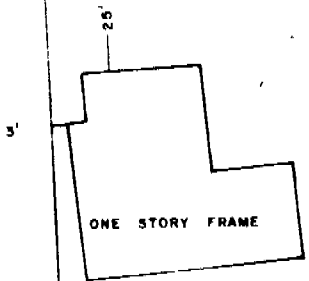

31

32

33

N 12° 15' E →  
167.1

174.6  
← S 12° 15' W

23 AC.

OLD I.P.

60

OLD I.P.

← N 75° 50' W

11

PROPERTY OF  
**22171 RALPH N. HANDE & MATTIE S. HANDE**

LOCATED IN GREER, S. C.

GREENVILLE COUNTY SOUTH CAROLINA

SCALE 1" = 30'


SURVEYED JANUARY 23, 1973

THIS IS TO CERTIFY THAT ON THIS DATE I SURVEYED THE PROPERTY SHOWN HEREON AND THE LINES ARE AS SHOWN, THAT THE BUILDINGS OR WALLS DO NOT ENCRACH ON ADJOINING PROPERTY, AND THAT THE BUILDINGS OR WALLS OF ADJACENT PROPERTY DO NOT ENCRACH ON THIS EXCEPT AS SHOWN.

PLAT BOOK REF. BOOK 0 PAGE 13 DEED REF. BOOK 287 PAGE 88

555-634 v

WOLFE & HUSKEY  
 ENGINEERS and SURVEYORS

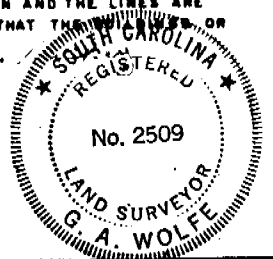

FILED 02/08/73  
 GREENVILLE CO. S. C.  
 1973 JAN 23 11 55 AM  
 DORRIS & HARRIS  
 REGISTERED LAND SURVEYORS

Plat Recorded February 6, 1973 at 12:58 P.M. S. C. # 22171