


BLOCK BOOK NO
 T 31-3-1
 T 31-3-2.1
 T 31-3-2.3
 T 31-3-8

OWNER	LENGTH OF SEWER THRU PROPERTY	LENGTH OF R/W THRU PROP.	MANHOLES
ELIZABETH A. ASKINS LOYD A. BEATTIE EDMUND L. POTTER VIRGINIA P. CRIGLER RAYMATH A. HUMPHREYS	560	565	2
EVERETT B. MAUNEY	340	410	
GORDON O. & MARIAN L. ESTES	60		
BELMONT CORP. OF GREENVILLE	390	430	

ⓐ REVISION - ADDITIONAL R/W ON LOTS 1, 2, 3, 4 & 8
 11-10-70
 ⓑ REVISED LINE ON T 31-3-5.9 12-30-70


T-31-3-1	Edna International Corporation	290	285	1
T-31-3-1.1	Robert E. & Betty S. Biles	30	30	1
T-31-3-1.2	Marilyn M. Dragoomb	90	90	1
T-31-3-1.3	Samuel Claude Steyene	90	90	1
T-31-3-1.4	William Earl & Shirley L. Wagon	90	90	1
T-31-3-1.5	William T. Kellett	90	90	1
T-31-3-1.6	John W. & Martha W. Neel	90	90	1
T-31-3-1.7	Robert Eugene Miller	90	90	1
T-31-3-1.8	Pauline Sarah Adsett	120	120	1
T-31-2-1	COCHRAN, RUBY WALKER	197	205	1
T-31-2-2	BURNETT, C. WERTZ & SUE E	150	150	1
T-31-2-3	GREGORY, WALKER S. JR. & CHERRIE E	180	180	1
T-31-2-4	COCHRAN, SHIELDS	180	190	1
T-31-1-1	F. R. HAWKINS	275	285	1

REV. 1. ADDED LOT 1.5 & REVISED FOOTAGE ON LOTS 1 & 5.2
 2. REV. DIST. & M.H. ON LOTS 1, 1.5, & 5.2

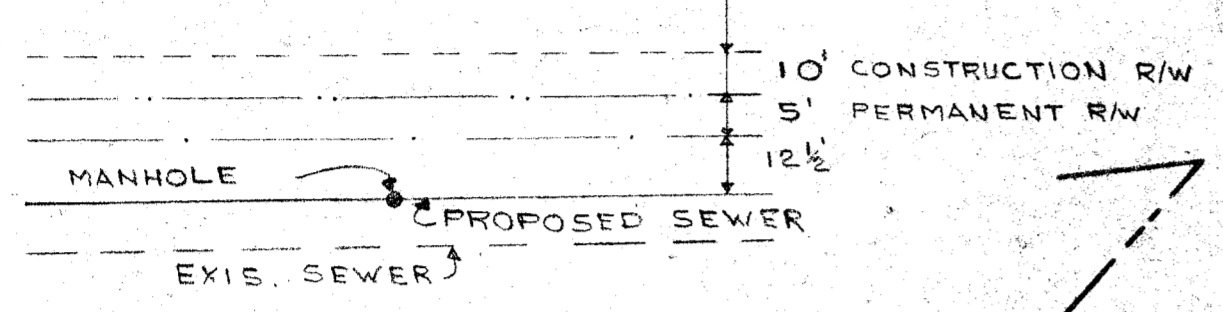

T30

T32

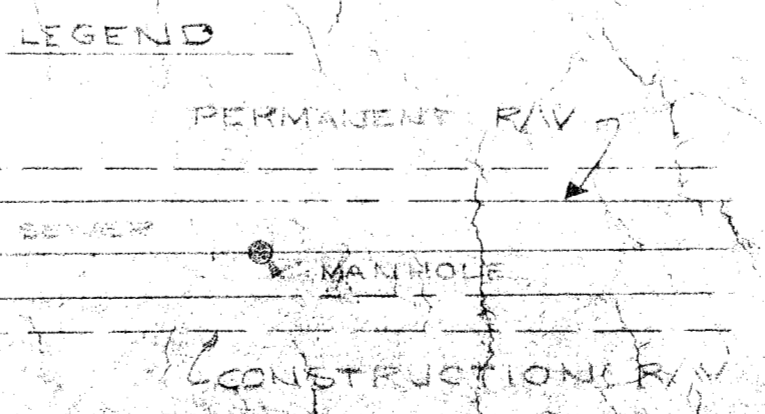

Taylor's Fire and Security
 District Commission

28905-A
 TTT-140
 APR. 20, 1973

GREATER GREENVILLE TAX MAPS GREENVILLE, S. C.		
TAX DISTRICT	MAP NUMBER	REVISION
276	T-31	
271		

SCALE 1" = 40'