































**BAD COPY**

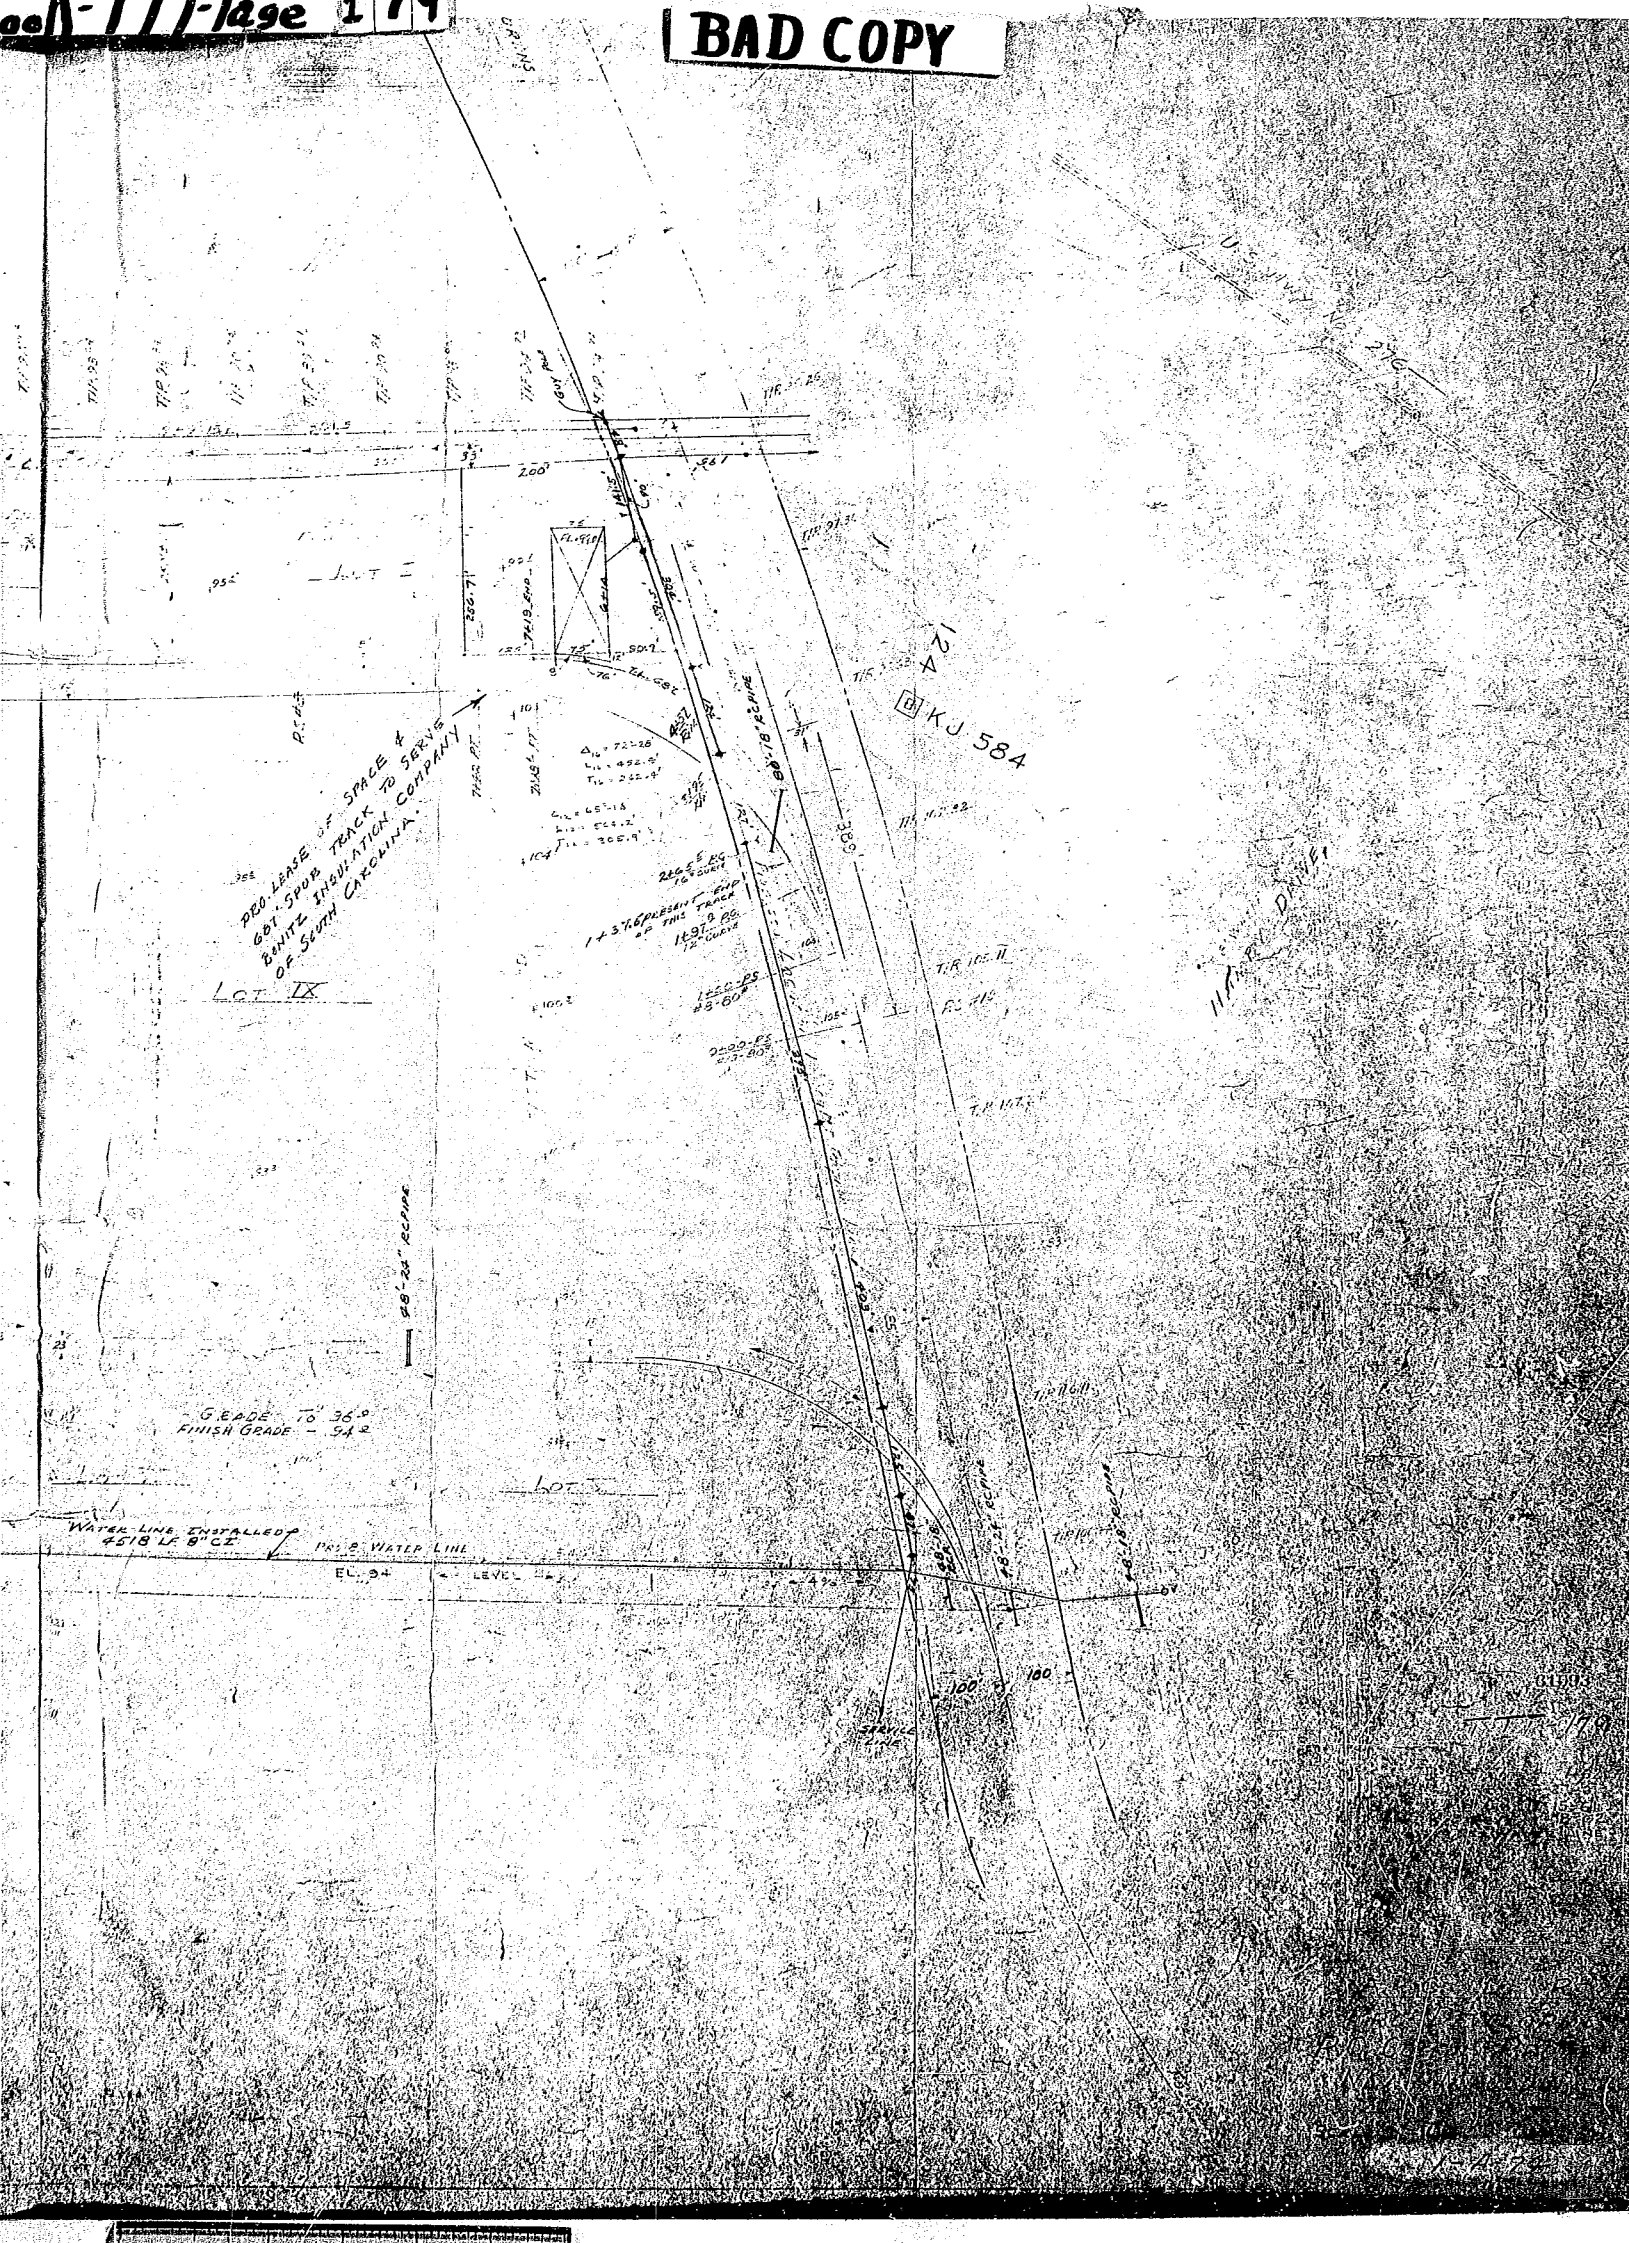

PROPOSED LEASE OF SPACE &  
 OF SOUTH CAROLINA

KJ 584

GRADE TO 36.0  

WATER LINE INSTALLED  
 4518 LF 8" CI

PR. 2 WATER LINE  

LOT

86' 24" RADIUS

TIR 105.11

R. 115

T.M. 107.14

110.100

86' 24" RADIUS

86' 24" RADIUS

100

100

Δ = 72.28  
 L = 452.9  
 T = 222.3

Δ = 65.18  
 L = 504.2  
 T = 205.9

 12' CURVE






