

9701
 And Recorded
 Register Map
 Greenville County, S.C.

OCT 2 3 25 PM 1967
 CLIVE E. HARRIS
 F.M.C.

9701 - Oct. 2, 1967

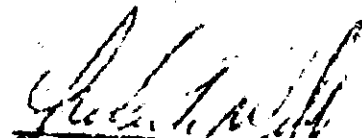
I hereby certify that on Aug. 8, 1967 I surveyed
 the above lot according to a plat recorded in
 plat book 504 on page 27 in the R.M.C. in the
 Office of Greenville County; and that the property
 lines, buildings and walls are as shown hereon,
 that no wells or buildings encroach on adjacent
 streets or property and no buildings or walls
 encroach or project on these premises except as
 shown.

PROPERTY OF
JOHNNY JUNIOR YESNEY

NEAR THE CITY OF GREENVILLE
 GREENVILLE COUNTY S.C.

WEBB SURVEYING & MAPPING CO.
 SCALE 1"=40' AUG. 8, 1967

CHARLES F. WEBB
 REGISTERED
 1577
 LAND SURVEYOR
 SOUTH CAROLINA


 Charles F. Webb R.L.S.

9701

BLK. BK. REF. T 31-13

Plat in 504 VVV-27