Plat Book-VVV-Page 121A

14759 Filed This 22 day of Nov 19 67
And Recorded in Vol. VVV Page 121 at 9:23 A.M.
Ollie Farnsworth
Register Mesne Conveyance Greenville County, S. C.

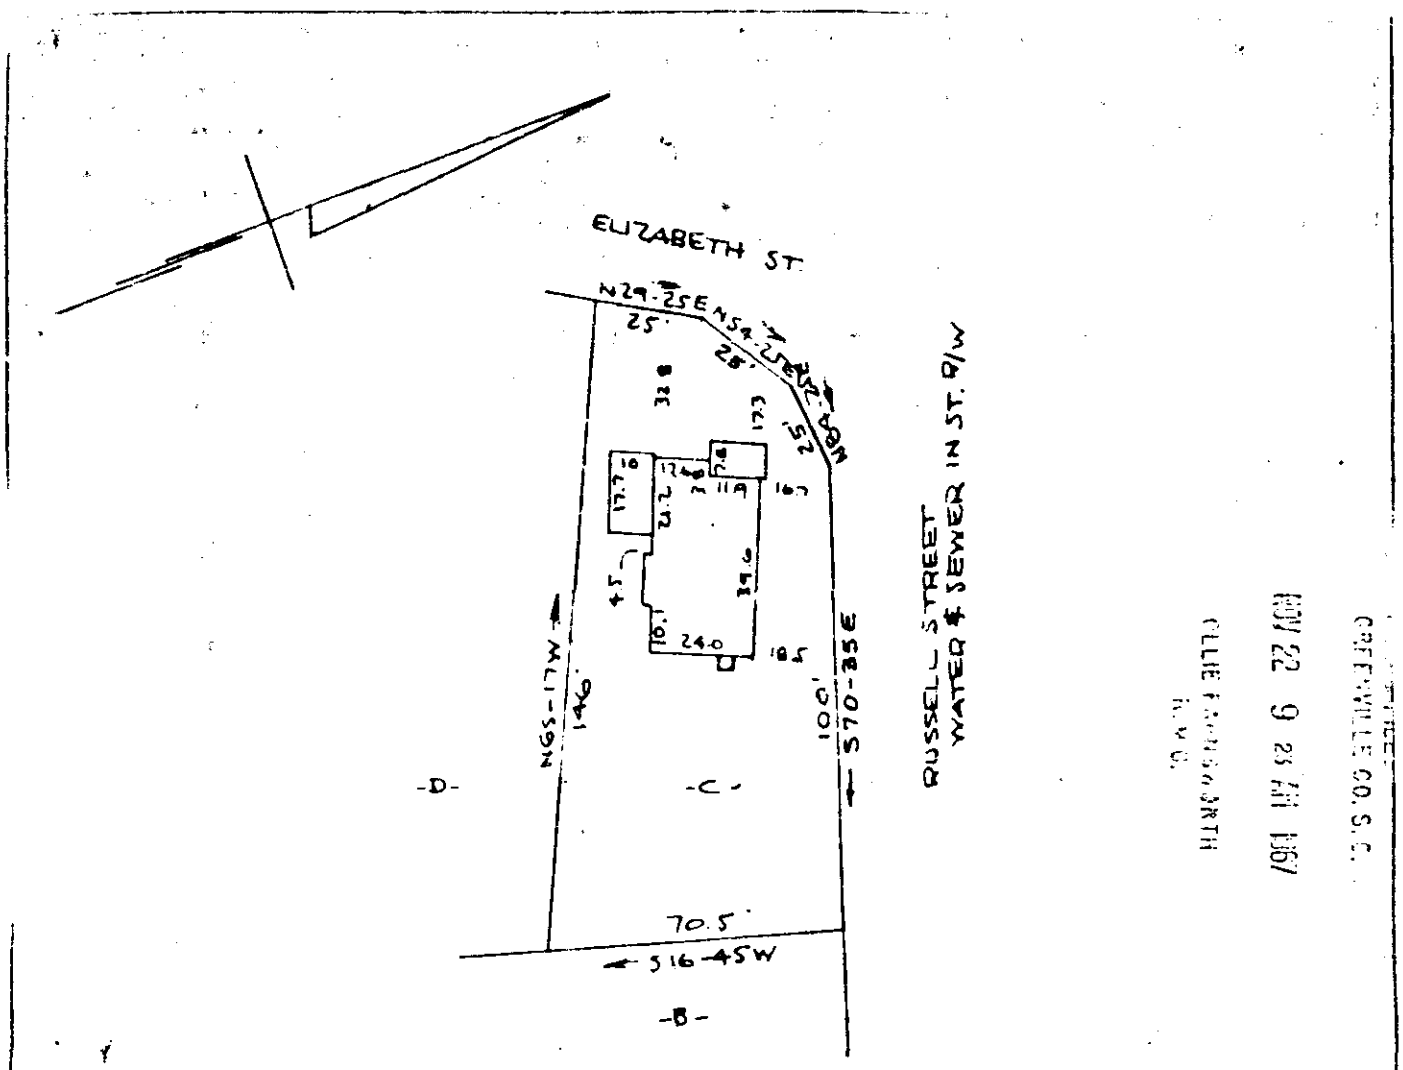

This is to certify that on the 19th day of November 1967, I surveyed the property shown on this plat, being known as lot "C" on plat of NORTH HILLS and recorded in the R.M.C. Office Greenville County, S.C. in plat book "H" page 88, and also being known as property of RONALD G. DUNCAN and CAROLINDA M. DUNCAN and recorded in the R.M.C. Office in plat book m page ; and that the property lines, walls and buildings are as shown hereon, and that the buillings located on said lot do not encroach or project on adjacent street or property, and that no adjacent buillings or walls encroach or project on said premises.

R. B. Bruce
R. B. Bruce R.L.S. # 1952.

14759

Ser 506
VVV-121

CAROLINA ENGINEERING AND SURVEYING CO.
GREENVILLE, S.C.

NOV 22 9 23 AM 1967
OLLIE FARNSWORTH
R.M.C.
GREENVILLE CO. S.C.