


171 1000 V V V 125 4 25 171

#15269 FILED THIS 28th Nov 1967
And Registered in V.V.V. Page 125 at 4:35 P.M.
Oliver J. Prevatte

Register Marine Conveyance Greenville County, S. C.

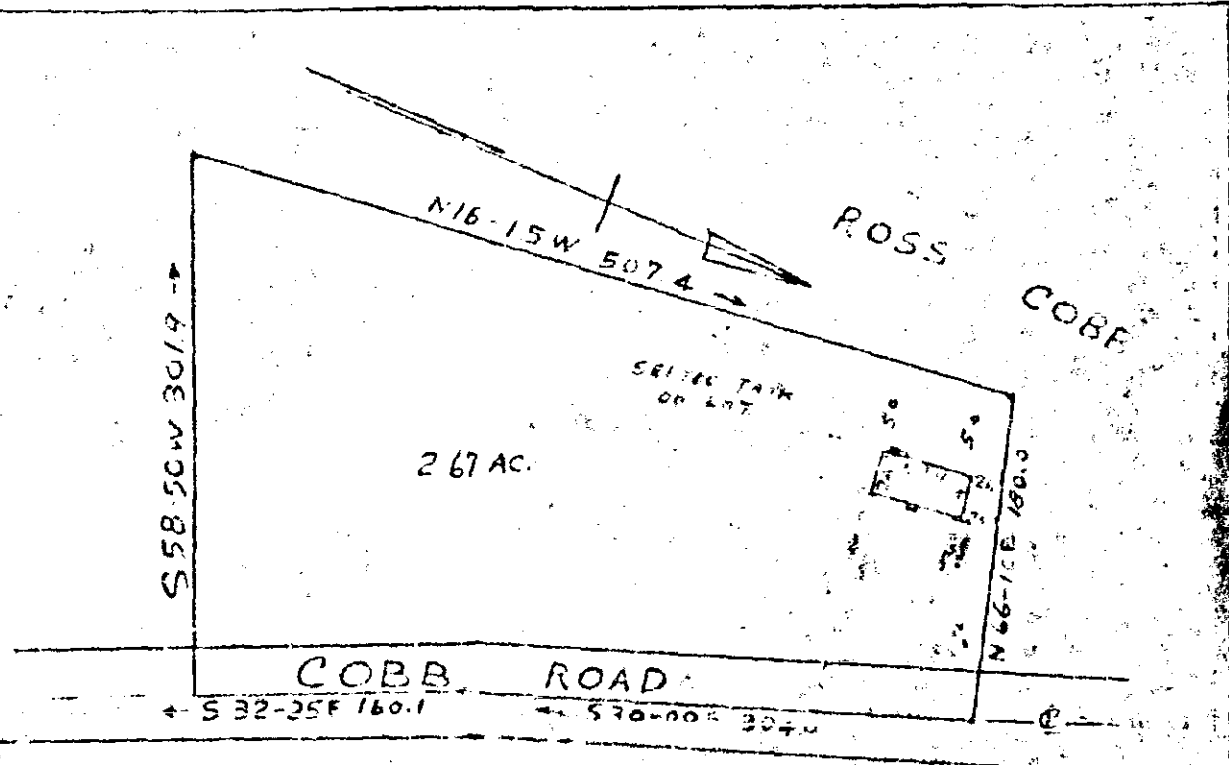

PROPERTY OF
ROBERT LEE COBB & JOHNETTA COBB
GREENVILLE CO., S.C. SCALE 1"=100'

This certifies that on 7th November 1967,
I surveyed the property shown hereon, the
building is located as noted, that no
walls or buildings encroach or project on
adjacent property, and that no
buildings on adjacent property encroach
on this property.

J. M. Prevatte
J. M. Prevatte, R. L. S. S. C. 2302

PLAT DRAWN BY
Grace L. Prevatte
5th Nov. 1967
GREENVILLE CO., S. C.
NOV 28 4 35 PM 1967
OLIVER J. PREVATTE
S. C.

NOV 27 1967

15269

B-1, P-49

504
VVV-125

125