



16425 Filed This 11th day of Dec. 1967
 And Recorded in Vol. VVV Page 137
 Ollie Farnsworth
 Register Marine Conveyance Greenville County, S. C.

For original to this plat see plat book NNN - 81.

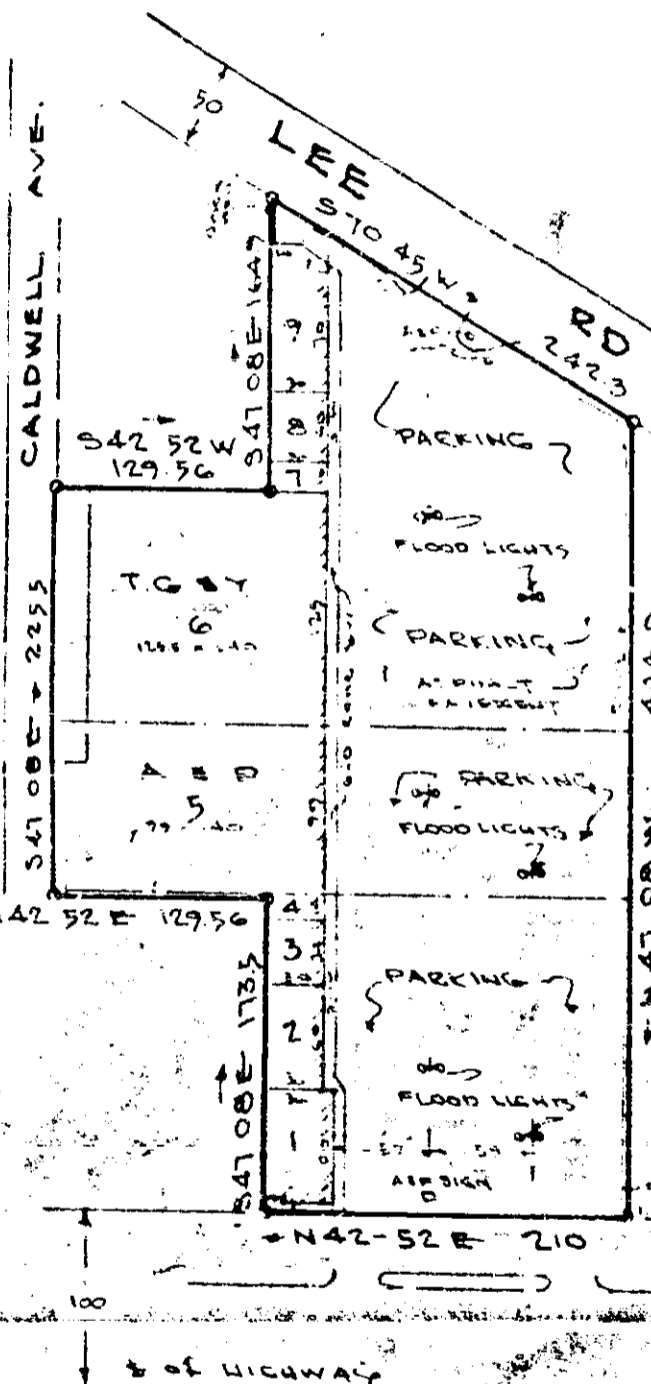

- 1 PIZZA INN
- 2 DOCTOR'S OFFICE
- 3 DENTIST OFFICE
- 4 FLOWER & GIFT SHOP
- 5 A&P SUPER MARKET
- 6 T.G. & Y. VARIETY STORE
- 7 BARBER SHOP
- 8 BEAUTY SALON
- 9 DRY CLEANERS

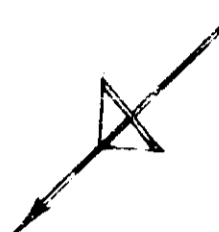

FILED
 GREENVILLE CO. S. C.
 DEC 11 2 00 PM 1967
 OLLIE FARNSWORTH

WADE HAMPTON BLVD.

PROPERTY OF
**NALLEY COMMERCIAL
 PROPERTIES INC.**
 GREENVILLE COUNTY, S. C.
 SCALE 1"=100' DECEMBER 1967

This is to certify that on the 4th day of Dec. 1967, I surveyed the property shown on this plat, being NALLEY COMMERCIAL PROPERTIES, INC., recorded in Plat Book _____ of the S. C. Office for Greenville County, S. C., and that the property lines, walls and buildings shown hereon: that the buildings, lot lines and walls do not encroach or project on adjacent property; and that no adjacent buildings or walls encroach or project on said property, and that no utility lines cross this property.

[Signature]

Reg. Engineer No. 1144 S. C.
 JONES ENGINEERING SERVICES - GREENVILLE, S. C.

VVV-137

137