


17750 Filed This 27 day of Dec. 1967
And Recorded in Vol. VVV Page 161 at 12:20 P.
Ollie Farnsworth
Register Meane Conveyance Greenville County, S. C.

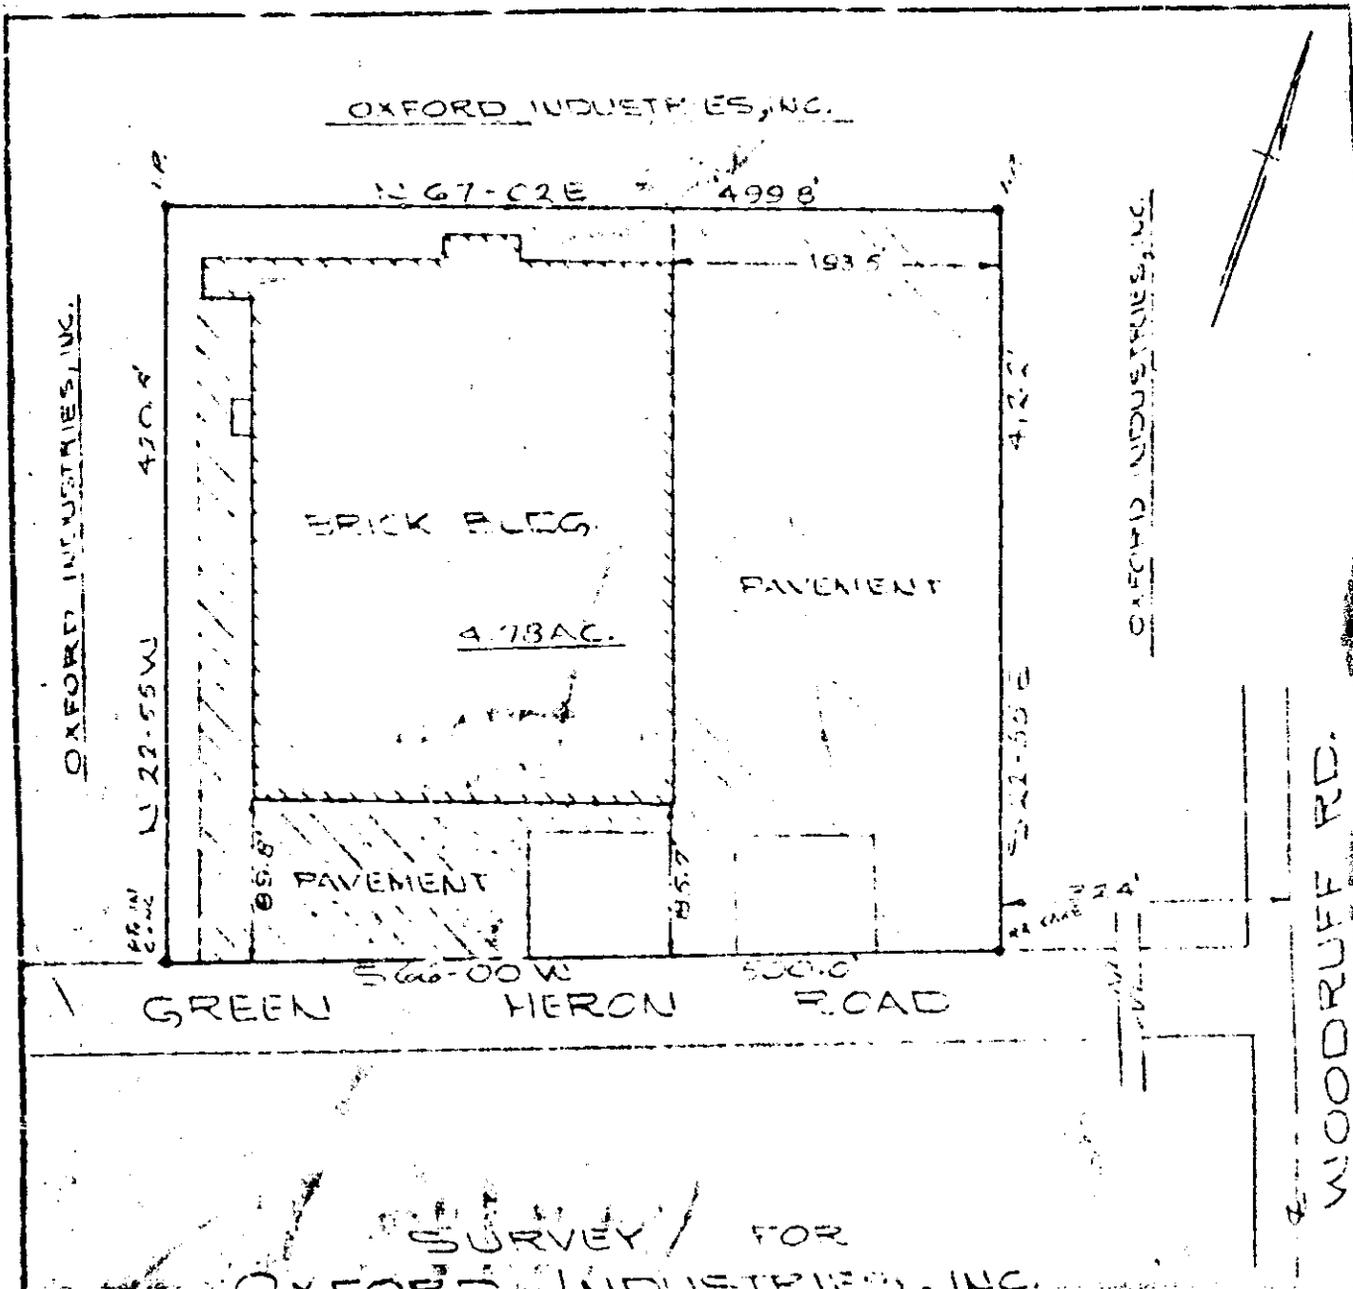

SURVEY FOR
OXFORD INDUSTRIES, INC.
NEAR GREENVILLE, S. C.
SCALE 1"=100' OCT 10, 1967

This is to certify that on the 11th day of October 1967, I surveyed the property shown on this plat; and that the property lines, walls and buildings are as shown hereon; that the buildings located on said lot do not encroach or project on adjacent streets or property; and that no adjacent walls or buildings encroach or project on this lot; and that there are no utility lines crossing this property except as shown.

Douglas S. Crouch

Douglas S. Crouch
Registered Engineer No. 962

PIEDMONT ENGINEERS AND ARCHITECTS
GREENVILLE, S. C.

50 f
VVV - 161 17750