
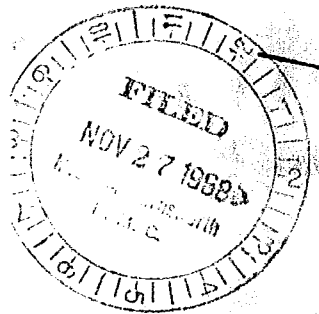


#13015 Filed This 27 Nov. 1968
 And Recorded in Vol. 222, 117, at 2:30 P.
 Ollie Jameworth
 Register Mesne Conveyance Greenville County, S. C.

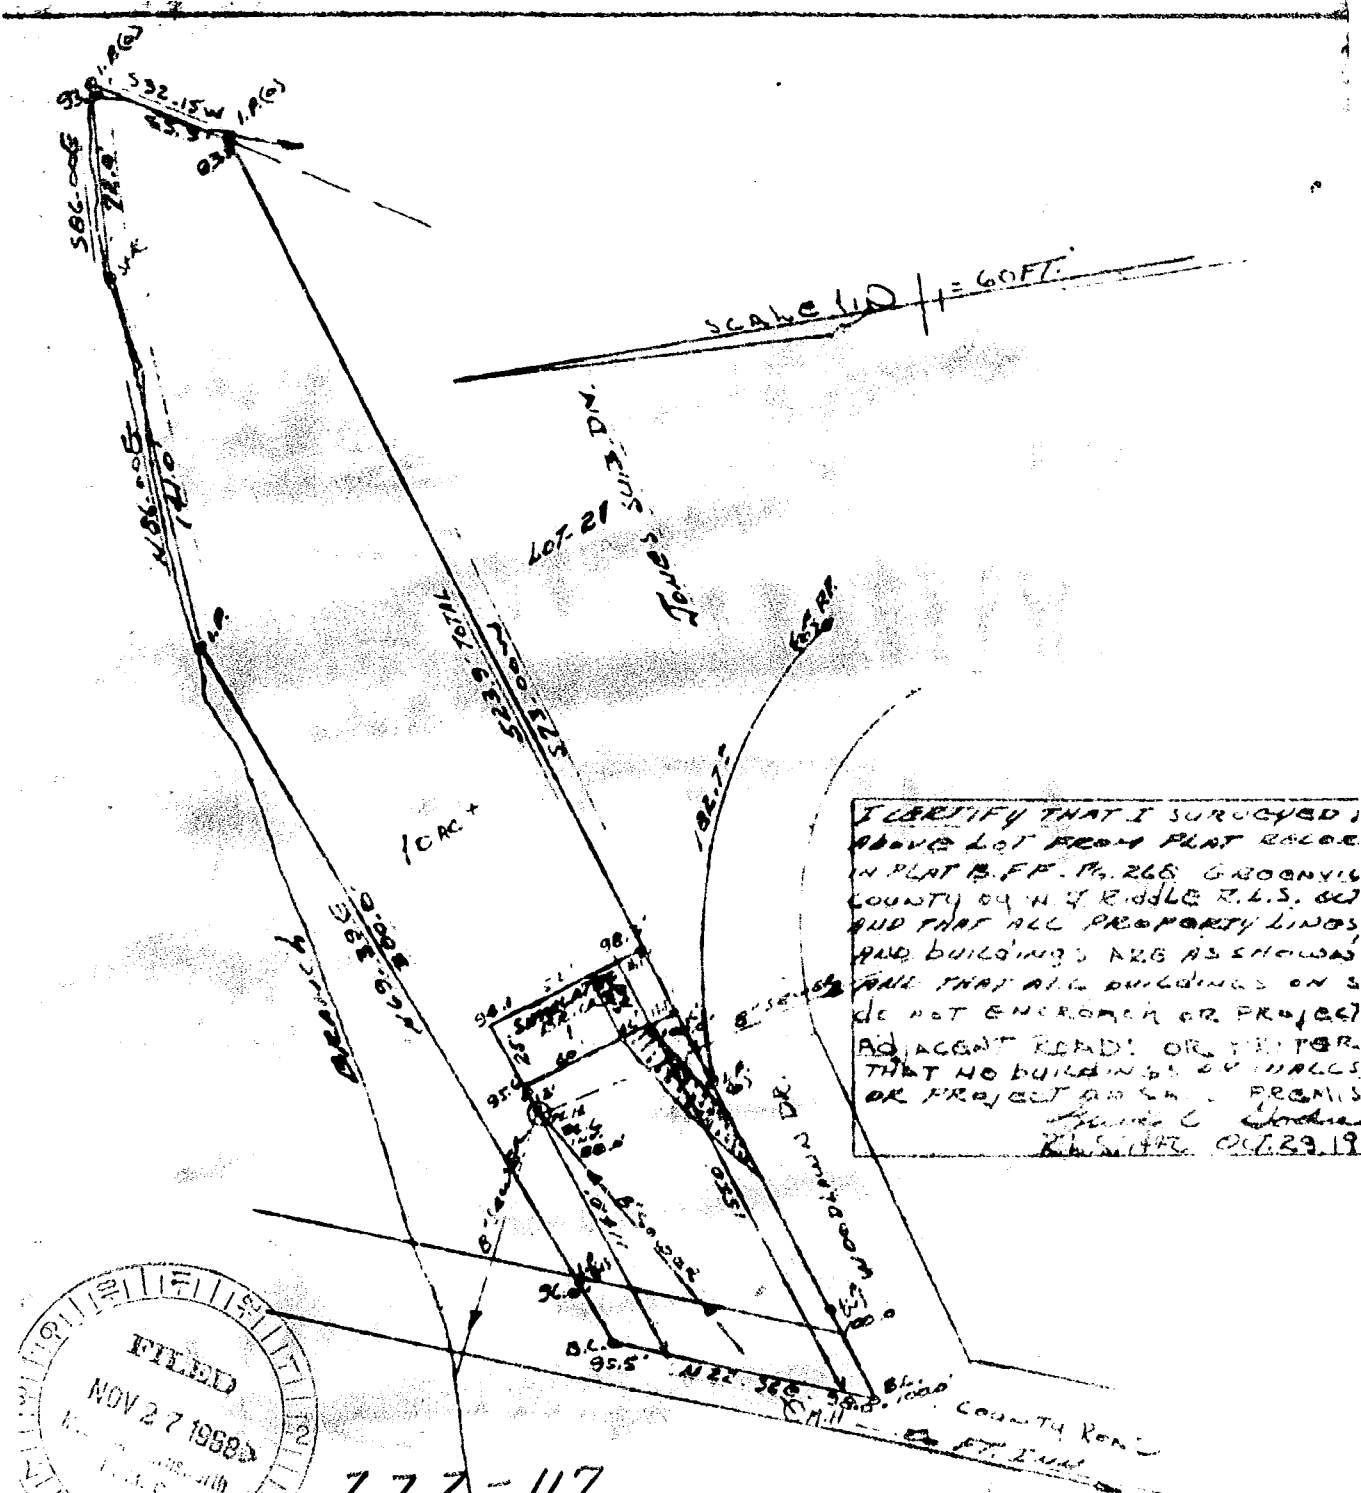

222-117
 PLOT PLAN
 PROPERTY OF
 HENRY & MATTIE M. BOYD
 LOCATED N. OF FT. INN, S.C.
 GREENVILLE COUNTY.

NOV 27 1968
 509 13015

NOTE: WATER & POWER SURVEYED BY LEWIS C. GOLDEN R.E.S.