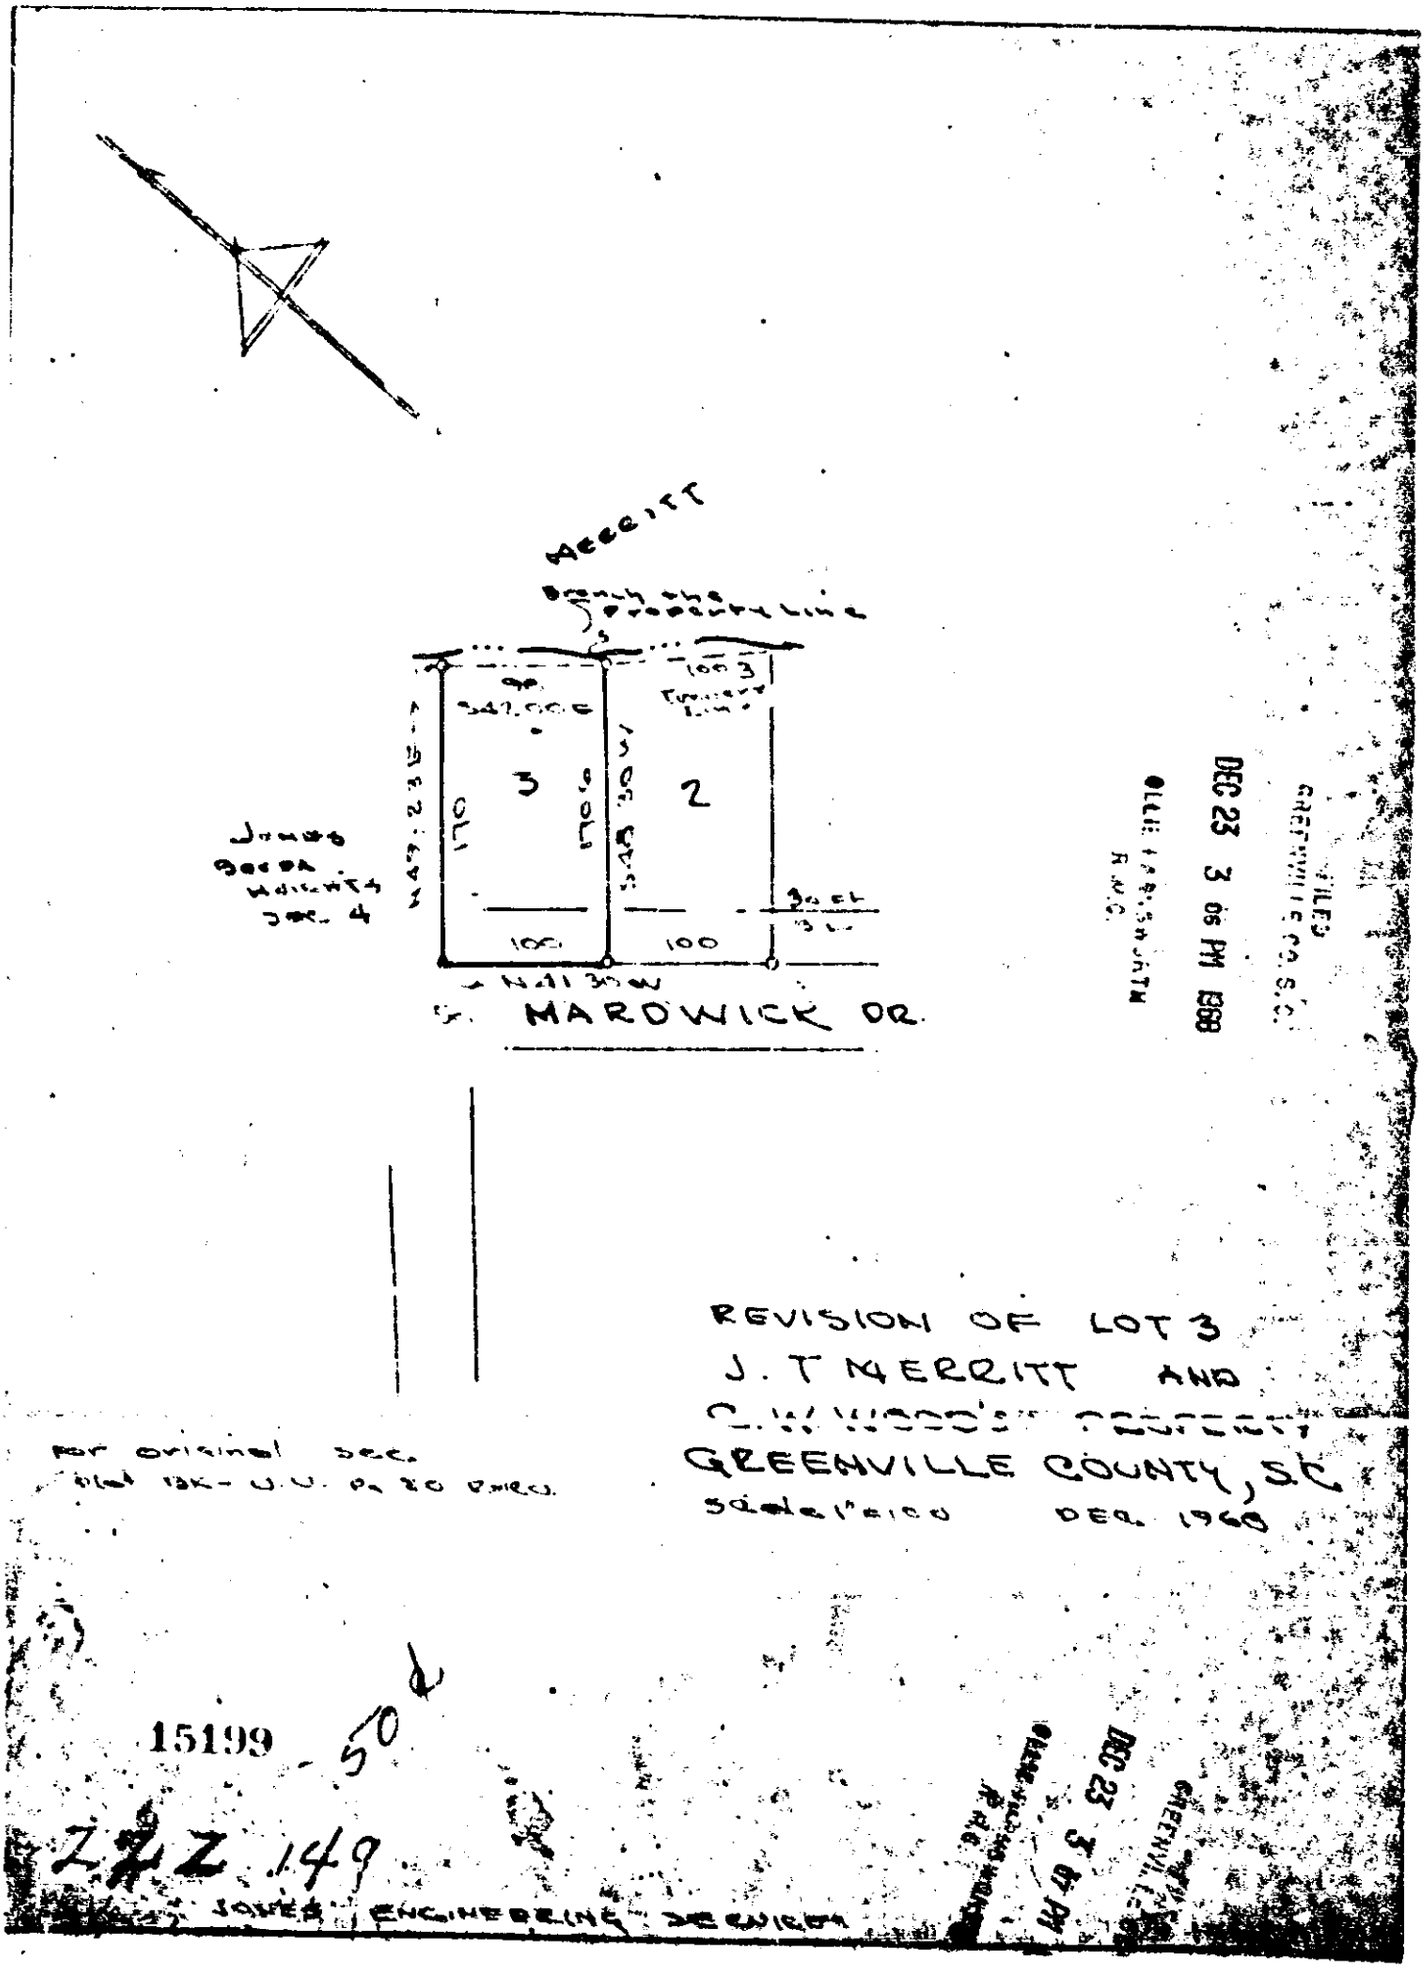15199 Filed This 23 day of Dec. 19 68
And Recorded in Vol. 777 Page 149 at 3:16 P.
Ollie Farnsworth
Register Mesne Conveyance Greenville County, S. C.