

Greenville
V023-0031

Carroll

Enc
92

Toll Line } Caesar Head Loop
(Name)

Or Exchange Line }
tributary to (Exchange)

The Property is bounded where the line enters and leaves this property by the property of:

State - v mtr Co on the N and

R. F. Johnson on the S


Number of poles covered by this permit 1

Number of Guys and Anchors 1

The poles have the following numbers: 1

from No. 135 to No.

Poles are located on private property and in Streets and Highways as shown on the following diagram.

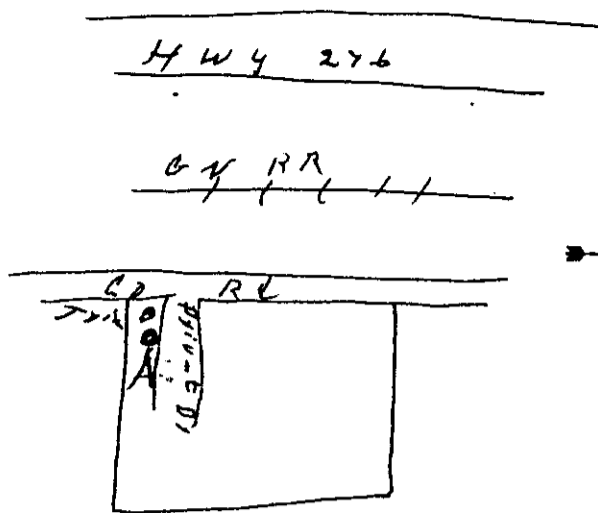

GENERAL PERMIT

Form 6196-A
(Sept., '40)

\$ 1.00 Received of the SOUTHERN BELL TELEPHONE AND TELEGRAPH COMPANY, (INCORPORATED)

One \$ 1.00 /100 Dollars in consideration of which I hereby grant unto said Company, its associated and allied companies, their respective successors and assigns, the right, privilege and authority to construct, operate and maintain its lines of Telephone and Telegraph, and for the general transmission of intelligence, consisting of such poles, wires, cables, conduits, guys, anchors and other fixtures and appurtenances as the grantee may from time to time require, upon, across, over and/or under the property which I own or in which I have any interest in the County of Greenville and State of S.C. and upon, along and/or under the roads, streets, or highways adjoining the said property, and the right to permit the attachment of and/or carry in conduit wires and cables of any other company or person, and with the further right to trim and cut down and to keep trimmed and cut down all trees and undergrowth within feet of said line, and in addition thereto, the grantee shall have the right to cut down, from time to time, all dead, weak, leaning or dangerous trees that are tall enough to reach the wires in falling; said sum being received in full payment for the rights herein granted.

Witness my hand and seal this 15th day of Feb. 1952, at Marietta SC
Witness Dewey King (L.S.)
C. J. Hoffer (L.S.)
W. H. Jarrard (Land Owner) (L.S.)
(Post Office Address)

STATE OF SOUTH CAROLINA,
COUNTY OF GREENVILLE

Personally appeared before me C. J. Hoffer
made oath that he saw M. H. Jarrard
sign and seal and as his true and lawful
agent he signed the foregoing instrument.

Sworn to before me, this 25th day of February A.D., 1952

Ollie Jamison (SEAL)
Notary Public, S. C.

Recorded February 25th, 1952 at 2:25 P. M. #4606