

BEAR & MILLS INC.

FILED GREENVILLE CO.

JAN 9 9 19 AM



Poles are located on private property and in Streets and Highways as shown on the following diagram.

Number of poles covered by this permit 3 on the 5  
Number of Guys and Anchors 4  
The poles have the following numbers:  
from No. 2063 to No. 2066

Exchange Line }  
Tributary to } (Exchange)  
The Property is bounded where the line enters and leaves this property by the property of:

Toll Line } ASHELWILLE - GREENVILLE  
(Name)

GREENVILLE, S.C. LONNAY  
J.O. 23-1128-79 W.G. Hancock  
CODE 97C S.V.R. G.R.P.

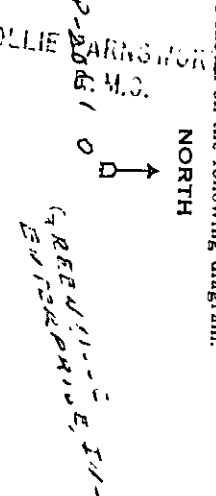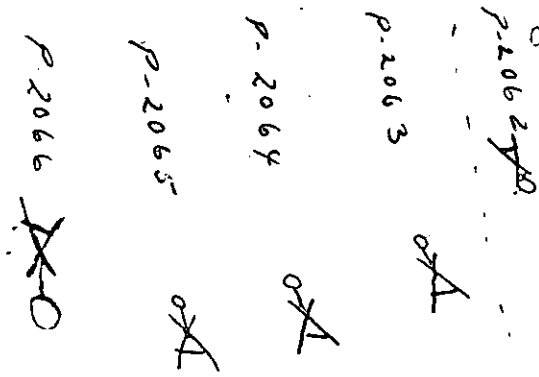

GENERAL PERMIT

Form 6196-A (Sept., '40)

Received of the SOUTHERN BELL TELEPHONE AND TELEGRAPH COMPANY, (INCORPORATED)

\$ 100 /100 Dollars in consideration of which I hereby grant unto said Company, its associated and allied companies, their respective successors and assigns, the right, privilege and authority to construct, operate and maintain its lines of Telephone and Telegraph, and for the general transmission of intelligence, consisting of such poles, wires, cables, conduits, guys, anchors and other fixtures and appurtenances as the grantee may from time to time require, upon, across, over and/or under the property which I own or in which I have any interest in the County of GREENVILLE and State of S.C. and upon, along and/or under the roads, streets, or highways adjoining the said property, and the right to permit the attachment of and/or carry in conduit wires and cables of any other company or person, and with the further right to trim and cut down and to keep trimmed and cut down all trees and undergrowth within 20 feet of said line, and in addition thereto, the grantee shall have the right to cut down, from time to time, all dead, weak, leaning or dangerous trees that are tall enough to reach the wires in falling; said sum being received in full payment for the rights herein granted.

Witness MY hand and seal this 16 day of OCT 19 52 at GREENVILLE S.C.  
Witness John W. Linberger (Post Office Address)  
W. A. Hancock (L.S.)  
BEAR & MILLS INC. PRES. (L.S.)  
W. W. PATE (Land Owner)

STATE OF SOUTH CAROLINA  
COUNTY OF GREENVILLE

Personally appeared before me W. A. Hancock  
made oath that he saw the within named W. W. PATE  
sign, seal and as his her their act and deed, deliver the within instrument  
that he with JOHN W. LINEBERGER witnessed the same  
Sworn to before me, this 8th  
W. A. Hancock  
Notary Public, S. C.

Recorded January 9th, 1953 at 9:19 A.M. #682