


For Agreement in connection with this Plat See Deed Book 487, page 457

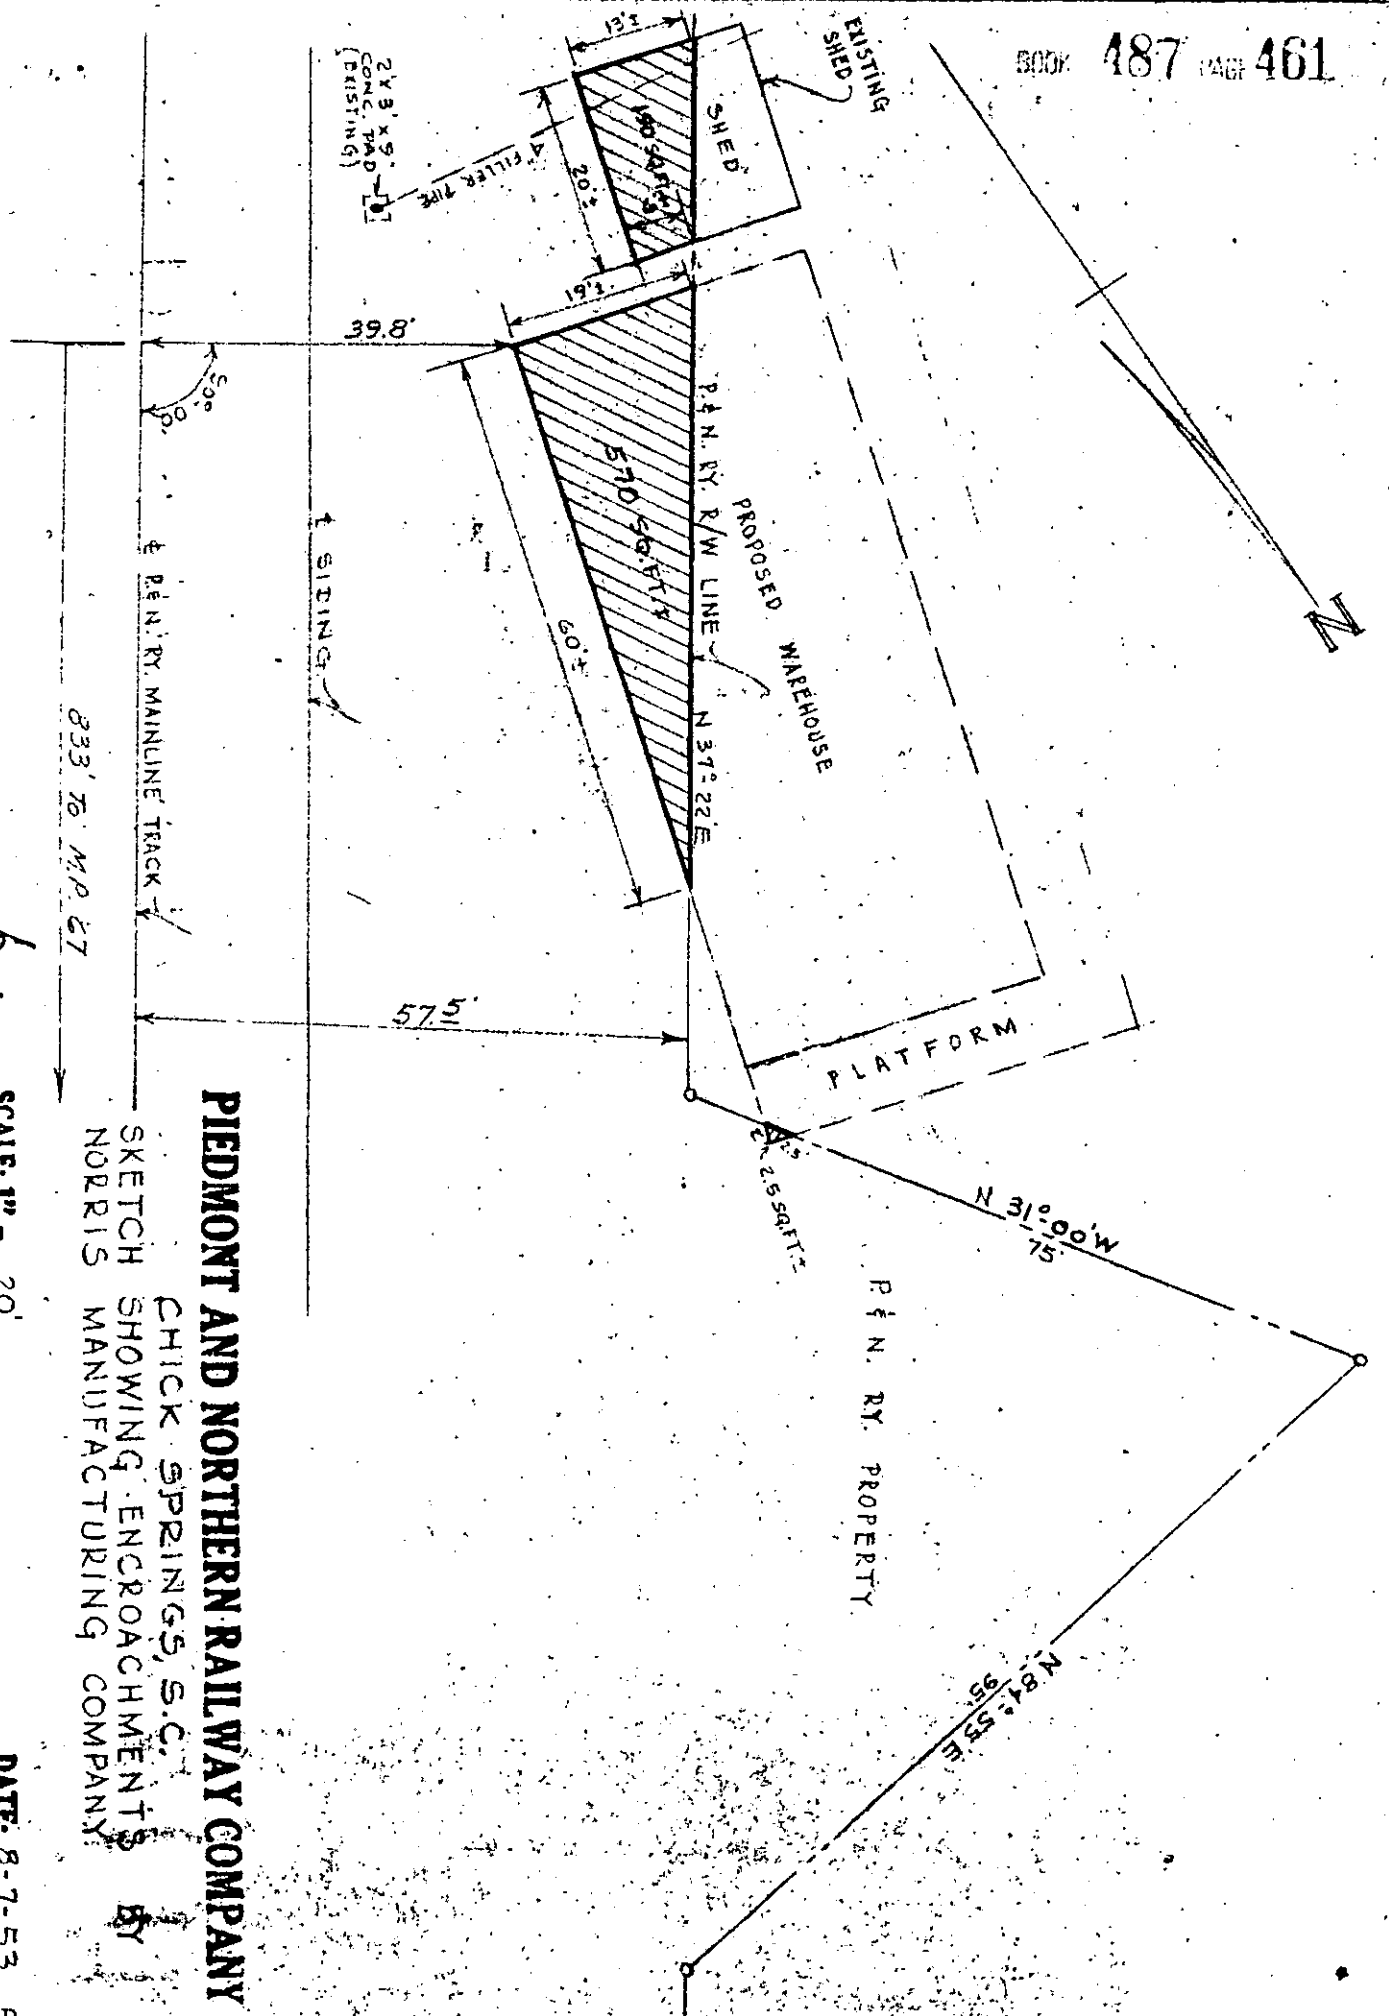

[Handwritten signature]

PIEDMONT AND NORTHERN RAILWAY COMPANY
 CHICK SPRINGS, S.C.
 SKETCH SHOWING ENCROACHMENTS
 NORRIS MANUFACTURING COMPANY

SCALE: 1" = 20'
 OFFICE OF CHIEF ENGINEER

DATE: 8-7-53.
 CHARLOTTE, N. C.

F-767

Plat Recorded October 23rd, 1953 at 10:00 A.M. #23222