


GREENVILLE S.C. Council  
S-3667 R.A. Bowen

498 115  
Toll Line (Name)  
Exchange Line (Exchange)  
GREENVILLE, S.C.  
tributary to  
The Property is bounded where the line enters and leaves  
this property by the property of:  
CITY OF GREENVILLE  
HOUSING AUTHORITY on the E. and

C&W.C. RAILWAY CO. on the W.  
Number of poles covered by this permit 3  
Number of Guys and Anchors 1  
The poles have the following numbers:  
from No. to No.

Poles are located on private property and in Streets and Highways as shown on the following diagram.

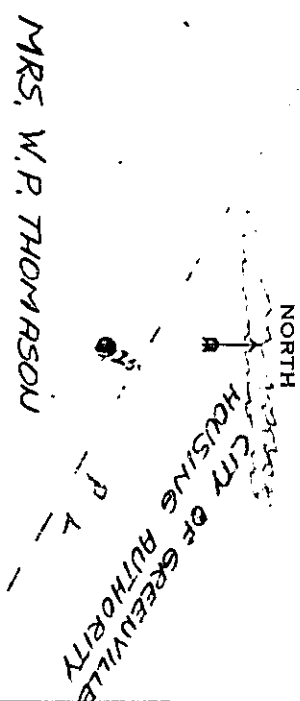

C & W.C. RAILWAY COMPANY  
C & W.C. R.R. Co.

APR 16 1954

Form 6196-A (Sept., '40)

GENERAL PERMIT

\$ 10.00 Received of the SOUTHERN BELL TELEPHONE AND TELEGRAPH COMPANY, (INCORPORATED)

Ten Dollars & No 100 Dollars in consideration of which I hereby grant unto said Company, its associated and allied companies, their respective successors and assigns, the right, privilege and authority to construct, operate and maintain its lines of Telephone and Telegraph, and for the general transmission of intelligence, consisting of such poles, wires, cables, conduits, guys, anchors and other fixtures and appurtenances as the grantee may from time to time require, upon, across, over and/or under the property which I own or in which I have any interest in the County of Greenville and State of South Carolina and upon, along and/or under the roads, streets, or highways adjoining the said property, and the right to permit the attachment of and/or carry in conduit wires and cables of any other company or person, and with the further right to trim and cut down and to keep trimmed and cut down all trees and undergrowth within 20 feet of said line, and in addition thereto, the grantee shall have the right to cut down, from time to time, all dead, weak, leaning or dangerous trees that are tall enough to reach the wires in falling; said sum being received in full payment for the rights herein granted.

It is expressly understood that this permit and/or right of way is to be confined to the present location of the lines and the poles as shown by the above diagram and sketch of the same on the premises.

Witness my hand and seal this 12th day of April 19 54, at Greenville, S.C. (Post Office Address)  
Mrs W. J. Thompson (L.S.)  
Mrs. W. J. Thompson (L.S.)  
MR. W. J. Thompson (Land Owner)  
R. A. Bowen

STATE OF SOUTH CAROLINA  
COUNTY OF GREENVILLE

Subscribed and sworn to before me  
R. A. Bowen  
Mrs W. J. Thompson Mrs W. J. Thompson  
Nesley M. Walker  
16th  
April 1954 R. A. Bowen  
Alice Starnes

9:41  
A. April 16th, 1954

498 115

Recorded April 16th, 1954 at 9:41 A.M. #8562