

K. C. 3-8213-A 9.7C

545 529

Toll Line } Greenville, S.C.  
(Name)

Or Exchange Line }  
(Exchange)

The Property is bounded where the line enters and leaves this property by the property of:

James, Edly, on the W and  
A. B. Forester, Ed on the E


Number of poles covered by this permit: 3

Number of Guys and Anchors:

The poles have the following numbers:

from No. 120 to No. 122

Poles are located on private property and in Streets and Highways as shown on the following diagram.

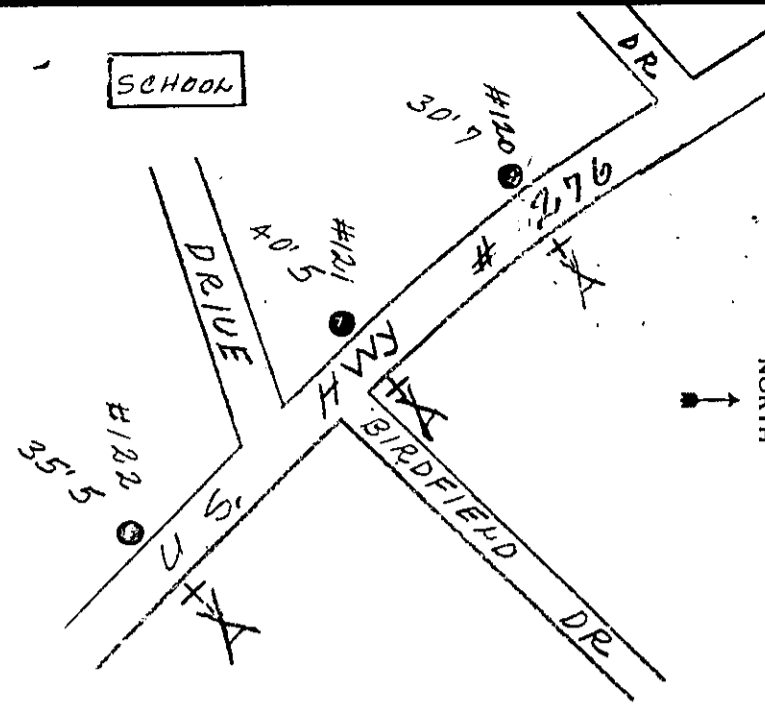

Form 6186-A (Sept., '40)

GENERAL PERMIT

\$100 Received of the SOUTHERN BELL TELEPHONE AND TELEGRAPH COMPANY,

One and NO/100 Dollars in consideration of which I hereby grant unto said Company, its associated and allied companies, their respective successors and assigns, the right, privilege and authority to construct, operate and maintain its lines of Telephone and Telegraph, and for the general transmission of intelligence, consisting of such poles, wires, cables, conduits, guys, anchors and other fixtures and appurtenances as the grantee may from time to time require, upon, across, over and/or under the property which I own or in which I have any interest in the County of Greenville and State of S.C. and upon, along and/or under the roads, streets, or highways adjoining the said property, and the right to permit the attachment of and/or carry in conduit wires and cables of any other company or person, and with the further right to trim and cut down and to keep trimmed and cut down all trees and undergrowth within 5 feet of said line, and in addition thereto, the grantee shall have the right to cut down, from time to time, all dead, weak, leaning or dangerous trees that are tall enough to reach the wires in falling; said sum being received in full payment for the rights herein granted.

Witness my hand and seal this 14 day of Feb 1956 at Greenville, S.C.  
Witness Roy C. Taylor  
Clara S. Elrod  
ROY, C. TAYLOR W.H. Harden  
CLARA S. ELROD

1956 at Greenville, S.C.  
(Post Office Address)  
W. F. Loggins, Supt.  
Greenville County Schools  
W. F. LOGGINS, SUPT (Land Owner)  
GREENVILLE COUNTY SCHOOLS.

STATE OF SOUTH CAROLINA  
COUNTY OF GREENVILLE

Personally appeared before me W. H. Harden and  
made oath that he saw the within named W. F. Loggins  
sign, seal and as his her their act and deed, deliver the within instrument, and  
that he with Clara S. Elrod witnessed the execution  
thereof.

Sworn to before me this 22 day of Feb, A.D., 1956  
H. Geo. Beckwith (SEAL)  
Notary Public, S. C.

W. H. Harden  
Recorded Feb. 22, 1956 at 11:58 A.M.  
# 4686