


mail

58' 6" M
ENOREE RIVER

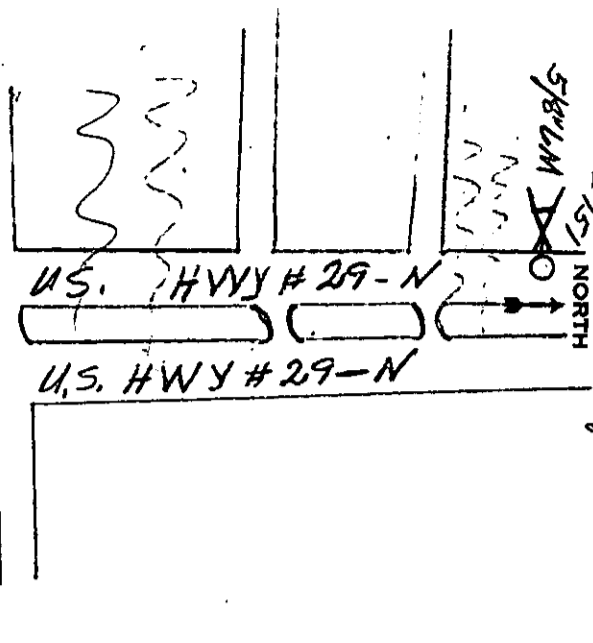

Title Andrew Monk
Approved J. A. Blythe
Area Greenville, S.C.
Authority S-3604 Classification 9-ITC
The poles (or stakes) have the following identification: R140-141 No. 151

Name and Post Office Address of Grantor F. J. Bishop
Toll Line Greenville Green
Exchange Line Greenville
Or Exchange Line tributary to (Exchange)

MAY 11 1956

GENERAL PERMIT + 12106 (INDIVIDUAL) Form 8416 Nov. '54

Received of the SOUTHERN BELL TELEPHONE AND TELEGRAPH COMPANY One and No. 100 Dollars in consideration of which (I) ~~(we)~~ hereby grant said Company, its associated and allied companies, their respective licensees, successors and assigns, the right to construct, operate and maintain a line of communication consisting of such poles, wires, cables, conduits, guys, anchors and other necessary appurtenances as from time to time are required upon, across, over and/or under that certain tract of land situated in Greenville County, State of S.C., to-wit: that tract lying West of U.S. Hwy # 29 North Bounded on the North by Property of Andrew Monk South by Enoree River

and upon, along and under the roads, streets, or highways adjoining or through said property with the right to permit the attachment of and/or carry in conduit wires and cables of any other person or company for communications purposes or for the transmission and distribution of electric power and the right of ingress and egress to said premises at all times for the purpose of inspecting and maintaining said line and with the right to clear and keep cleared all trees, undergrowth or other obstructions within a strip of land 5 feet on each side of the center of said line and to trim and cut and keep trimmed and cut all dead, weak, leaning or dangerous trees which might reach said line in falling; including the right to relocate said line on said premises to conform to any future highway relocation, widening or improvement; the said sum being received in full payment for the rights herein granted.

Signed, sealed and delivered in the presence of:
B. Frank Bishop
W.H. Harden
B. FRANK BISHOP

Executed May 9th, 1956
F. J. Bishop (SEAL)
F. J. BISHOP (SEAL)

ACKNOWLEDGMENTS For Use in South Carolina

Individual Form

STATE OF SOUTH CAROLINA }
COUNTY OF } ss.

Personally appeared before me W. H. Harden
and made oath that (he) ~~(she)~~, with B. Frank Bishop saw the within named F. J. Bishop
sign, seal, and deliver as (his) ~~(her)~~ ~~(their)~~ act and deed the within written instrument, and that (he) ~~(she)~~ with the said B. Frank Bishop witnessed the execution thereof.

Sworn to before me this 11 day of May A.D. 1956
J. A. Blythe Notary Public
Recorded May 11th, 1956 at 12:21 P.M. # 12106