


REEVES BROTHERS, INC.
MILLS MILL #1, GREENVILLE DIV.

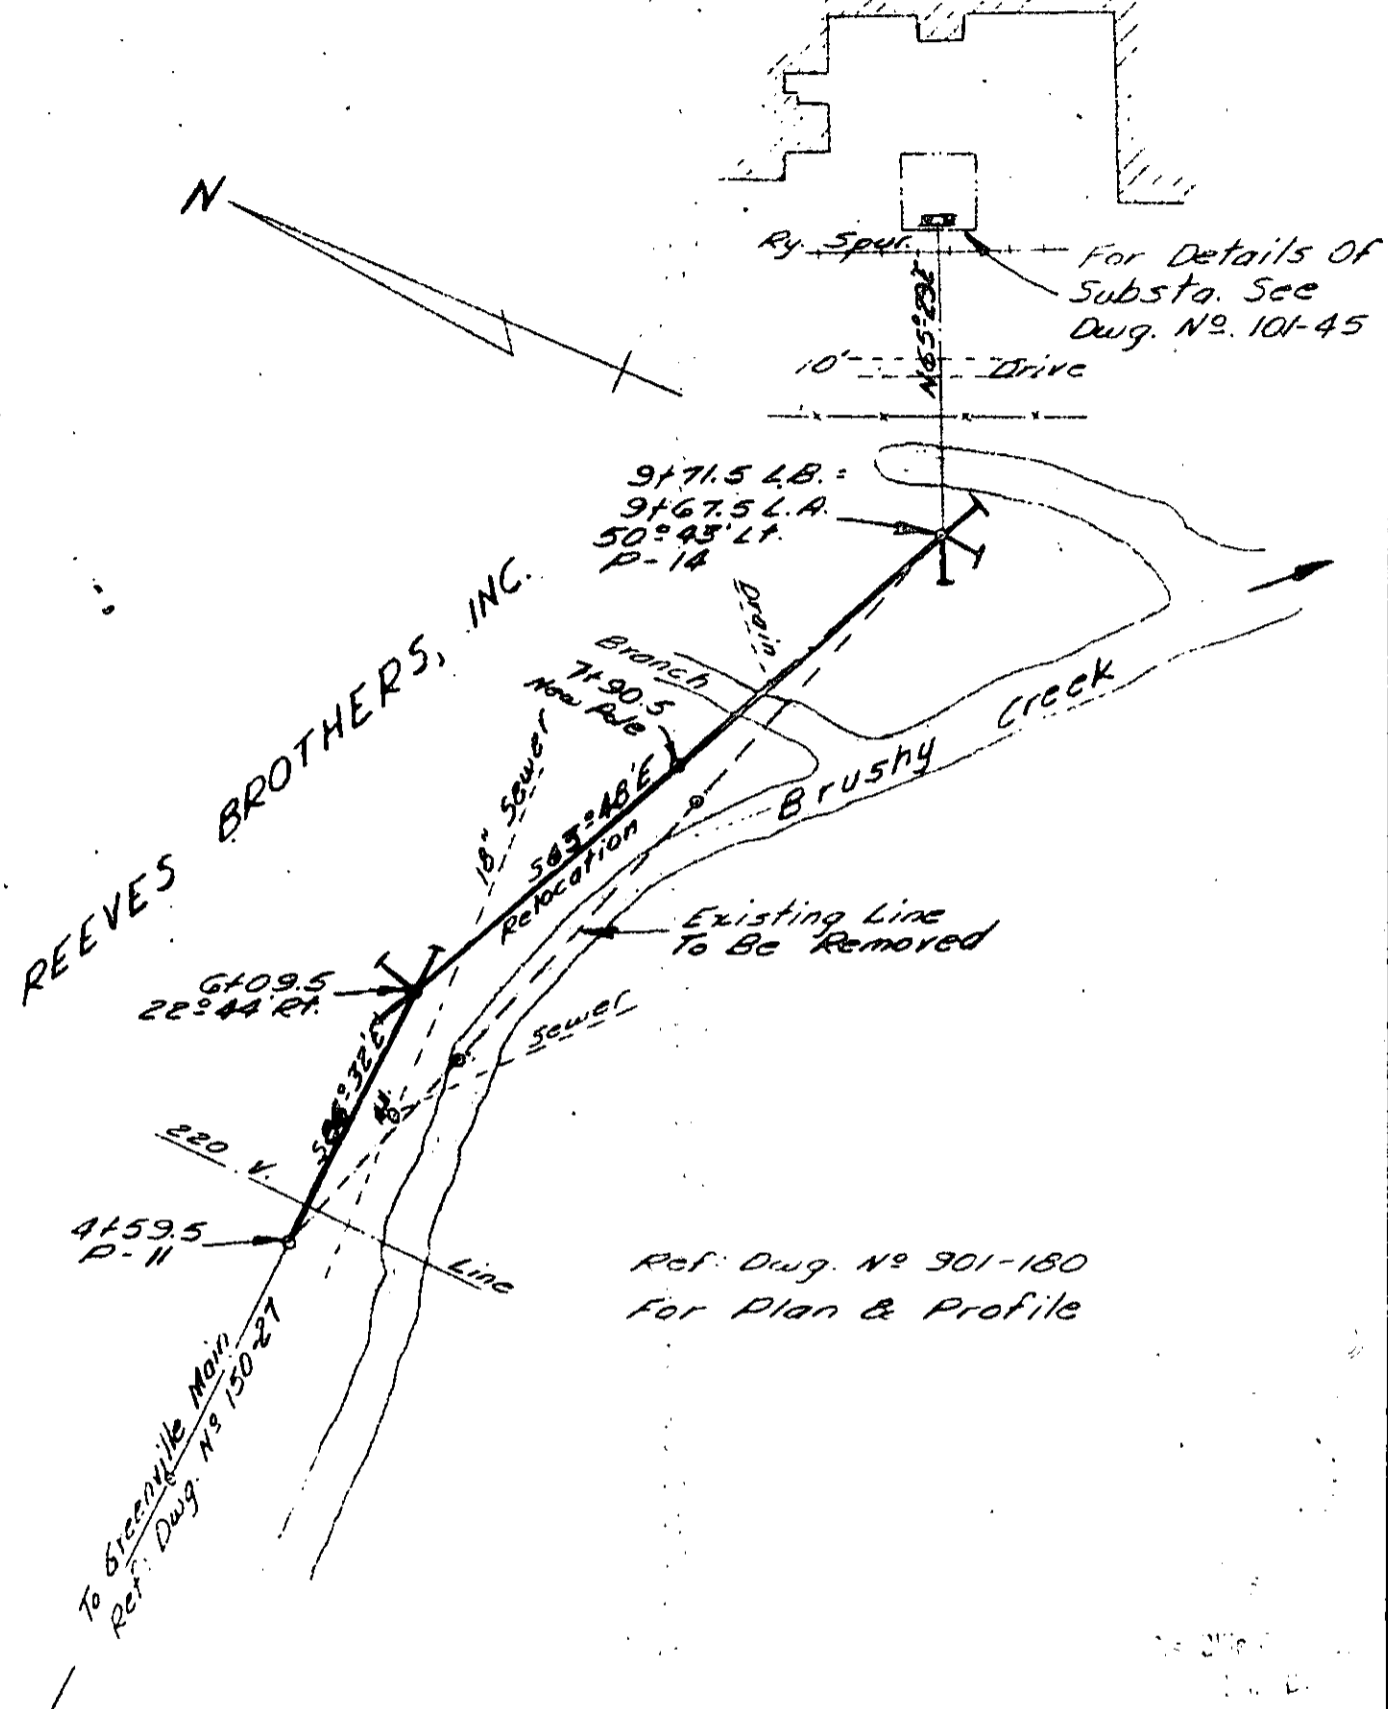

REEVES BROTHERS, INC.

9+71.5 L.B. =
9+67.5 L.A.
50°45' Lt.
P-14

Existing Line
To Be Removed

To Greenville Main
Ref. Dwg. No 150-27

Ref. Dwg. No 901-180
For Plan & Profile

DUKE POWER COMPANY
RELOCATION OF
TRANSMISSION LINE SERVING
REEVES BROTHERS, INC.
MILLS MILL #1, GREENVILLE DIVISION
GREENVILLE, S.C.

Note:
Name Changed
5-21-56
3 2 1 00

14213

SCALE: 1" = 100'

MAY 2, 1956

BOOK No 851

FILE No 15-135