


500 50

NOTE:  
LINE CONTINUED FROM RIGHT

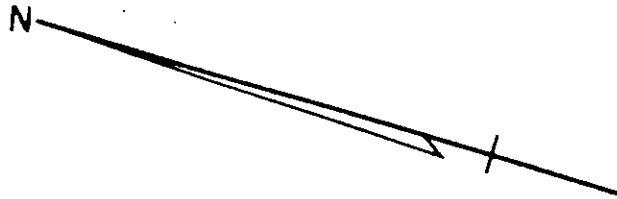

PLAN

SCALE: 1" = 100'

13+16.3  
47° 17' LT.

521° 05' W

BRANCH

PRESENT LINE TO BE REMOVED  
280.0'

REF: DWG. NO. 51-110

P-40

143.0'

18+58.3  
77° 19' LT.  
232.19'

522° 10' E

78.5' P-39  
TO OAKVALE SUBSTA.

NOTE:

MAP REVISED 7-24-56.

DUKE POWER COMPANY  
SUBSTATION LOT 8  
TRANSMISSION LINE  
TO SERVE THE  
GREATER GREENVILLE SEWER DISTRICT COMMISSION  
REEDY RIVER DISPOSAL PLANT  
GREENVILLE, S.C.

SCALES NOTED  
BOOK NO 423

APRIL 7 1955  
FILE NO. 52-84

Recorded August 28th, 1956 at 9:00 A.M. #21708

