


PROP. E. G. SLATER

BOOK 565 PAGE 07

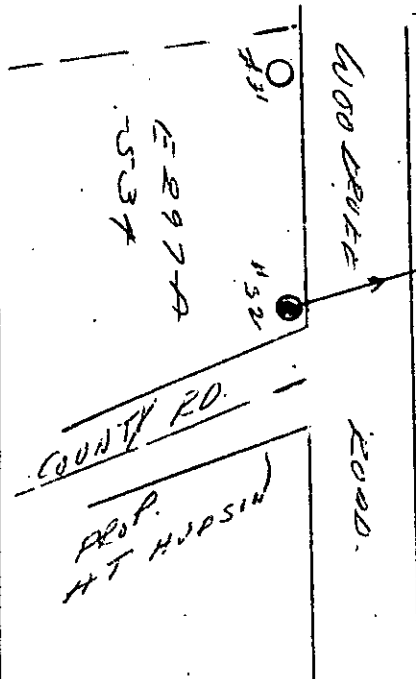

Name and Post Office Address of Grantor: Mr. Julius Green

Exchange Line tributary to: Greenville S.C.

The Property is bounded where the line enters and leaves this property by the property of: E. G. Slater on the W and H. T. Hudson on the E

The poles (or stakes) have the following identification: P. 31 to P. 32

Authority: EC-3823A Classification: 9C

Area: Greenville S.C.

Approved: [Signature]

Title: Superior

GEP 47.101

GENERAL PERMIT

(INDIVIDUAL)

Form 8416 Nov. '54

Received of the SOUTHERN BELL TELEPHONE AND TELEGRAPH COMPANY one dollar and no /100 Dollars in consideration of which ~~it~~ (We) hereby grant said Company, its associated and allied companies, their respective licensees, successors and assigns, the right to construct, operate and maintain a line of communication consisting of such poles, wires, cables, conduits, guys, anchors and other necessary appurtenances as from time to time are required upon, across, over and/or under that certain tract of land situated in Greenville County, State of South Carolina, to-wit:

that tract of land located along Woodruff Rd bounded on the west by the property of E. G. Slater and bounded on the east by property of H. T. Hudson

and upon, along and under the roads, streets, or highways adjoining or through said property with the right to permit the attachment of and/or carry in conduit wires and cables of any other person or company for communications purposes or for the transmission and distribution of electric power and the right of ingress and egress to said premises at all times for the purpose of inspecting and maintaining said line and with the right to clear and keep cleared all trees, undergrowth or other obstructions within a strip of land 10 feet on each side of the center of said line and to trim and cut and keep trimmed and cut all dead, weak, leaning or dangerous trees which might reach said line in falling; including the right to relocate said line on said premises to conform to any future highway relocation, widening or improvement; the said sum being received in full payment for the rights herein granted.

Signed, sealed and delivered in the presence of: 27957 Executed Oct 20, 1956.

[Signature] Mrs. Agnes S. Baling (SEAL)

T. Berry Baling NEE Miss Agnes Salter (SEAL)

MR. AGNES S. BALING (Wife)
NEE MISS AGNES SALTER (MRS)

GEP 47.101

Form 8426 Nov. '54

ACKNOWLEDGMENTS

For Use in South Carolina

Individual Form

STATE OF SOUTH CAROLINA

COUNTY OF Greenville } ss.

Personally appeared before me [Signature] and made oath that (he) (she), with T. Berry Baling saw the within named Agnes S. Baling sign, seal, and deliver as (his) (her) (their) act and deed the within written instrument, and that (he) (she) with the said T. Berry Baling witnessed the execution thereof.

Sworn to before me this 5th day of Nov, A.D. 1956.

[Signature] Notary Public

Recorded November 7th, 1956 at 9:00 A.M. #27957