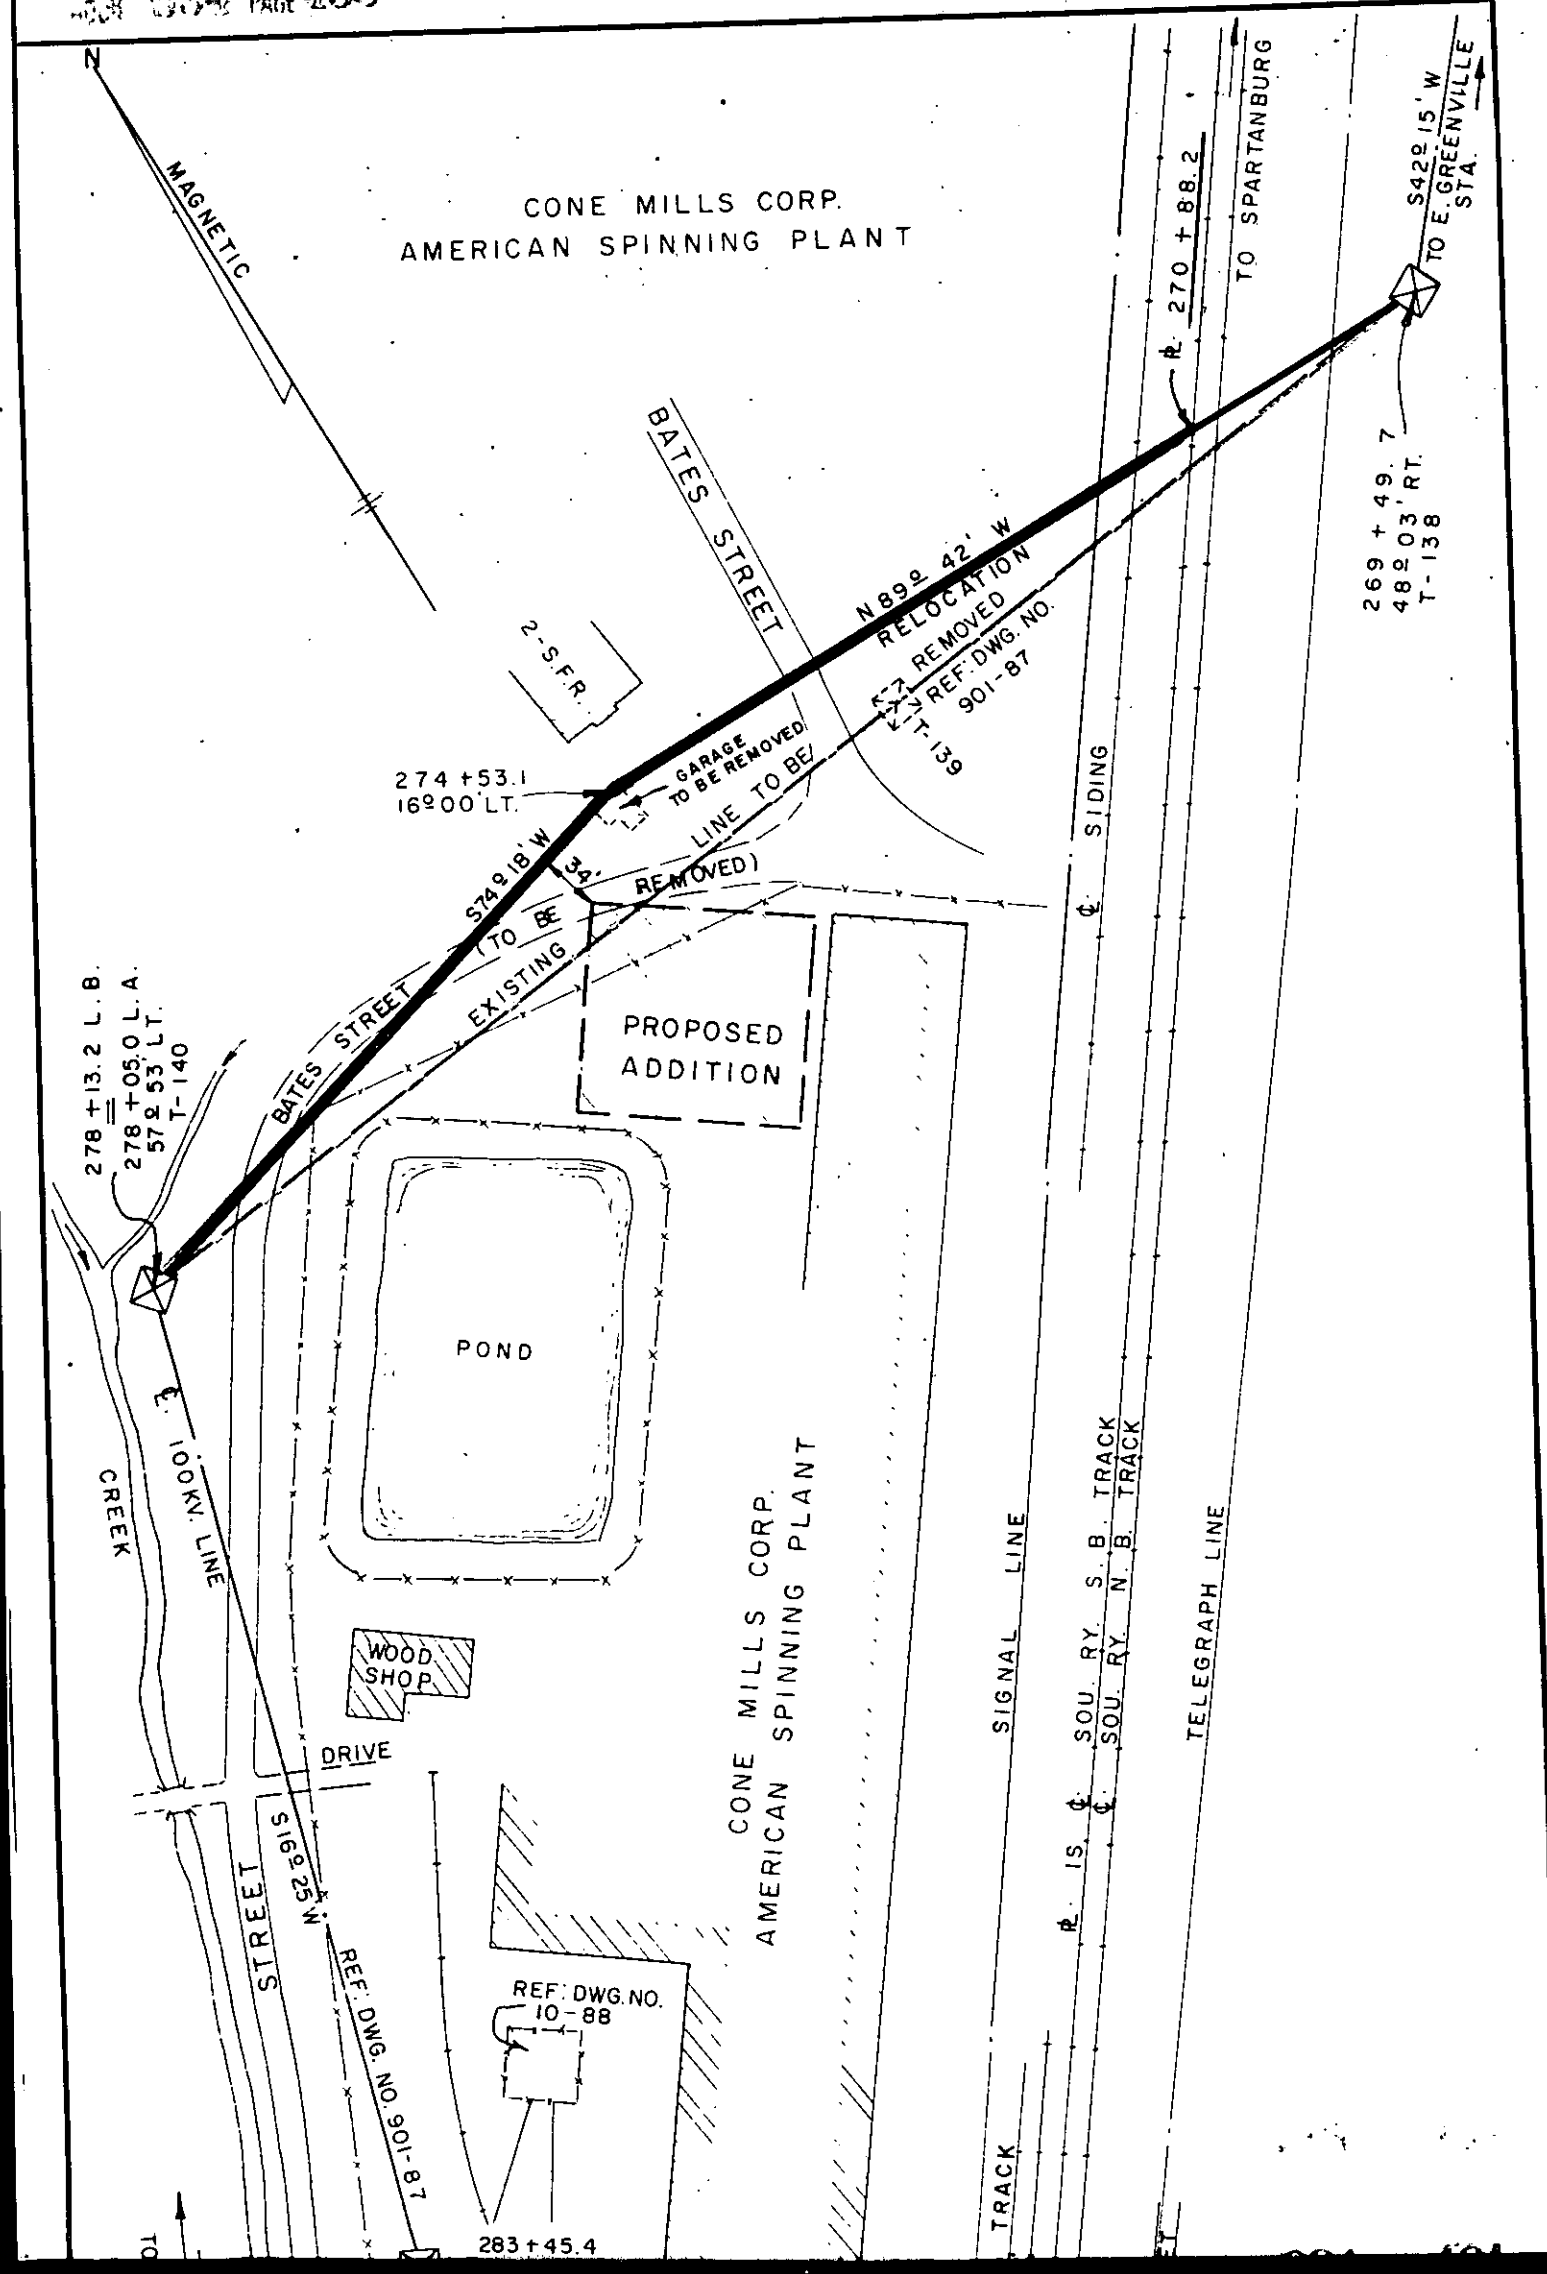
N
MAGNETIC
CONE MILLS CORP.
AMERICAN SPINNING PLANT
BATES STREET
2-S.F.R.
N 89° 42' W
RELOCATION
REMOVED
REF. DWG. NO. 901-87
T-139
270 + 88.2
TO SPARTANBURG
S 42° 15' W
TO E. GREENVILLE
STA.
269 + 49.7
48° 03' RT.
T-138
274 + 53.1
16° 00' LT.
GARAGE TO BE REMOVED
LINE TO BE REMOVED)
S 74° 18' W
34.
(TO BE
EXISTING
PROPOSED ADDITION
SIDING
278 + 13.2 L.B.
278 + 05.0 L.A.
57° 53' LT.
T-140
BATES STREET
POND
100 KV. LINE
CREEK
WOOD SHOP
DRIVE
S 16° 25' W
STREET
REF. DWG. NO. 901-87
REF. DWG. NO. 10-88
283 + 45.4
CONE MILLS CORP.
AMERICAN SPINNING PLANT
SIGNAL LINE
IS. ℄ SOU. RY. S.B. TRACK
℄ SOU. RY. N.B. TRACK
TELEGRAPH LINE
TRACK